IREDELL COUNTY HEALTH DEPARTMENT

STATESVILLE 704-878-5305 MOORESVILLE 704-664-5281

IMPROVEMENT PERMIT / CERTIFICATE OF COMPLETION / OPERATION PERMIT / EXISTING SYSTEM INSPECTION

PROPERTY DESCRIPTION NO. 10356 DATE 11-13-97 TAX MAP NO. 4736-94-4721

OWNER OR CONTRACTOR Jack Barker PHONE: Business Watershed: ☐ Yes ☐ No

ADDRESS 188 Knox Farm Rd Home 881-0025

LOCATION 21 N to Statesville to Nixon to Cooper Fm corner Clearview Rd

SUBDIVISION Willowbrook BLOCK / SECTION LOT 4 LOT AREA .46 acres SITE CLASS. D3 DESIGN FLOW 360 L.T.A.R. .33

Septic Tank: 1000 Gallons; STB 1012 Date 3-17-98

Pump Tank: Gallons; PT Date

Pump Make: Model Serial No.

Nitrification Field: No Fields 1 Square Feet 1080 Linear Feet 360

No Lines 4 Trench Width 36" Max Trench Bottom Depth 36" Gravel Depth 12"

☑ New System ☐ Repair System Type: I, (II) III, IV, V, VI

System Description: Conv. Gravity

Repair System Description: Pump To chambers

Maintenance Agreement Required: ☐ Yes ☑ No

☑ House/Mod. Home No. Bedrooms 3

☑ Mobile Home No. Bathrooms 2

☐ Business No. Employees

☐ Other


☐ Slab ☑ Crawl Space ☐ Basement w/plumbing ☐ Basement wo/plumbing

Water Supply: ☐ Individual ☑ Community ☑ Public

Comments:

Comments:

INITIAL SITE SKETCH

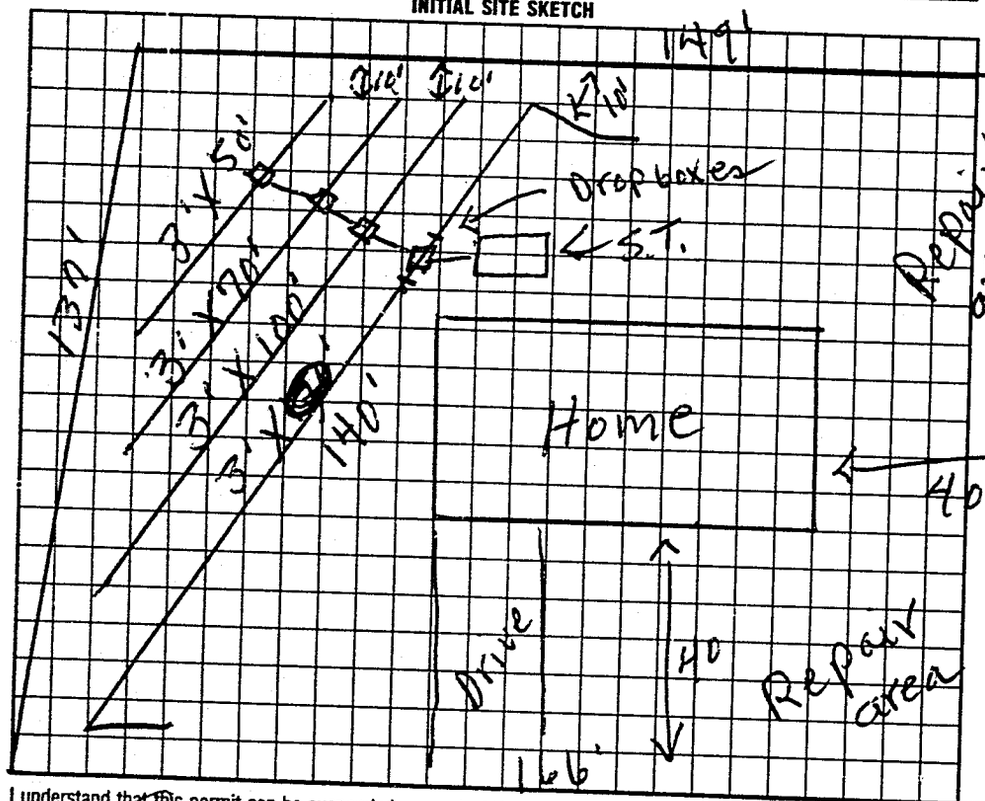

AS BUILT SKETCH

Same as initial sketch

I understand that this permit can be suspended or revoked if any false information is supplied toward securing the permit/any unauthorized changes are made to the site/any unauthorized changes are made in the installation of the system. Improvement Permit is valid for 60 months from date of issuance.

Signed:

Improvement Permit by: P.C. Moore date 11-13-97

Existing System Inspection by: P.C. Moore date 11-13-97

Authorization to Const.

Installed by: Dale Fox

Certificate of Completion by: date

Operation Permit by: P.C. Moore date 5-26-98

Authorization to const EXPIRES 60 mos FROM ISSUE

HEALTH DEPT. COPY: WHITE INSPECTION COPY (FINAL): GREEN OWNER COPY (FINAL): YELLOW INSPECTION COPY (INITIAL): PINK OWNER COPY (INITIAL): GOLD