IREDELL COUNTY HEALTH DEPARTMENT

STATESVILLE 704-878-5305 MOORESVILLE 704-664-5281

IMPROVEMENT PERMIT / CERTIFICATE OF COMPLETION / OPERATION PERMIT / EXISTING SYSTEM INSPECTION

PROPERTY DESCRIPTION NO. 6973470983 DATE 10-9-97 TAX MAP NO. 4736847965

OWNER OR CONTRACTOR Jack Barkers PHONE: Business Home

ADDRESS 168 Kinex Fm Rd Watershed: ☐ Yes ☐ No

LOCATION 2 IN TL Shumaker TL Nixon TL Cooper Fm on Rt before clearview Rd

SUBDIVISION Willowbrook BLOCK / SECTION LOT 3 LOT AREA 1.34 acres SITE CLASS. PS DESIGN FLOW 360 L.T.A.R. .33

Septic Tank: 1060 Gallons; STB 1012 Date 11-19-97

Pump Tank: Gallons; PT Date

Pump Make: Model Serial No.

Nitrification Field: No Fields 1 Square Feet 1080 Linear Feet 360

No Lines 4 Trench Width 36" Max Trench Bottom Depth 36" Gravel Depth 12"

☐ New System ☐ Repair System Type: I, II, ☑ III, IV, V, VI

System Description: Conv. Gravity

Repair System Description: Gravity chambers

Maintenance Agreement Required: ☐ Yes ☐ No

☑ House/Mod. Home ☐ Mobile Home ☐ Business ☐ Other

No. Bedrooms 3 No. Bathrooms 2 No. Employees


☐ Slab ☑ Crawl Space ☐ Basement w/plumbing ☐ Basement wo/plumbing

Water Supply: ☐ Individual ☐ Community ☑ Public

Comments:

Comments:

INITIAL SITE SKETCH

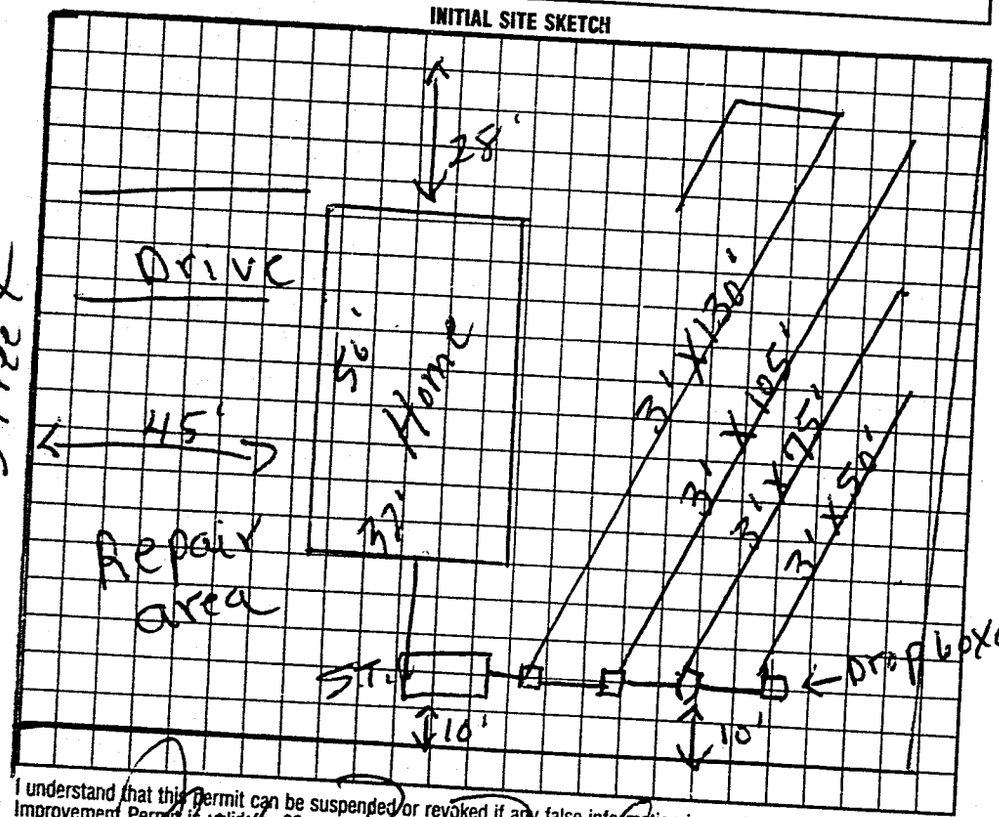

AS BUILT SKETCH

Installed as Shown

I understand that this permit can be suspended or revoked if any false information is supplied toward securing the permit/any unauthorized changes are made to the site/any unauthorized changes are made in the installation of the system. Improvement Permit is valid for 60 months from date of issuance.

Signed:

Improvement Permit by: L.C. Moore date 10-9-97

~~Existing System Inspection by:~~ Authorization to count L.C. Moore date 10-9-97

HEALTH DEPT. COPY: WHITE INSPECTION COPY (FINAL): GREEN OWNER COPY (FINAL): YELLOW

Installed by: Dale Fox

Certificate of Completion by:

Operation Permit by: Mat C (A) RS date 3-4-98

INSPECTION COPY (INITIAL): PINK OWNER COPY (INITIAL): GOLD

Authorization to count EXPIRES 60 MONTHS FROM ISSUE