IREDELL COUNTY HEALTH DEPARTMENT

STATESVILLE 704-878-5305 MOORESVILLE 704-664-5281

IMPROVEMENT PERMIT / AUTHORIZATION TO CONSTRUCT / OPERATION PERMIT / EXISTING SYSTEM INSPECTION

PERMIT# 79147 PIN# 4736944996 DATE 1-27-99

OWNER OR CONTRACTOR Jack G. Borders PHONE: Business 881 0025 Home

ADDRESS 188 Knox Fm Rd Statesville, N.C.

LOCATION 21 N TL Fort Dobbs TR Cooper Fm 1/2 mi left

SUBDIVISION Willowbrook BLOCK / SECTION LOT 2 LOT AREA 1.61 acres SITE CLASS PS DESIGN FLOW 360 L.T.A.R. .3

Septic Tank: 1000 Gallons; STB 1017 Date 4-7-99

Pump Tank: Gallons; PT Date

Pump Make: Model Serial No.

Nitrification Field: No. Fields 1 Square Feet 1200 Linear Feet 400

No. Lines 4 Trench Width 36" Max Trench Bottom Depth ~~36~~ 24" Gravel Depth 12"

☑ New System ☐ Repair System Type: I ☑ II III IV V VI

System Description: Conv. Gravity

Repair System Description: Gravity 25% Red

Maintenance Agreement Required: Yes ☐ No ☑

☑ House/Mod. Home No. Bedrooms 3

☐ Mobile Home No. Bathrooms 2

☐ Business No. Employees

☐ Other


Slab ☑ Crawl Space ☐ Basement w/plumbing ☐ Basement wo/plumbing

Water Supply: ☐ Individual ☑ Public ☐ Community


Comments/Conditions: 1121

Comments/Conditions:

INITIAL SITE SKETCH

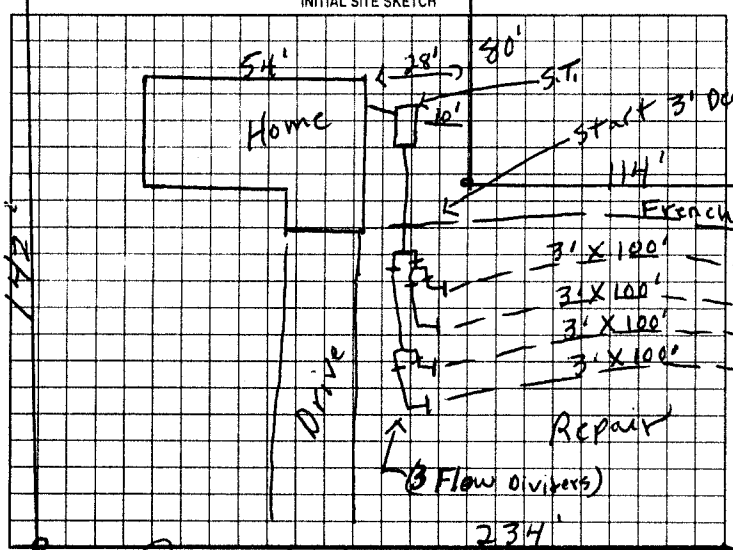

AS BUILT SKETCH

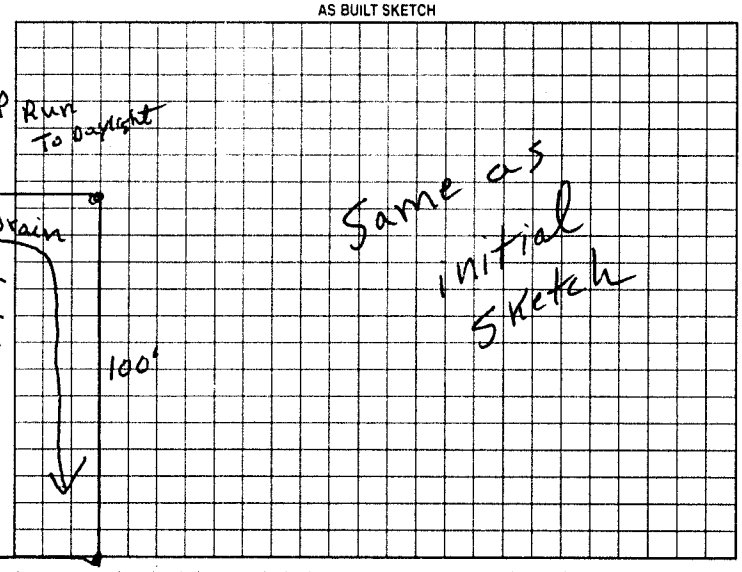

Permit can be suspended or revoked if any false information is supplied toward securing the permit/any unauthorized changes are made to the site/any unauthorized changes are made in the installation of the system. Improvement Permit with plat valid without expiration. Improvement Permit with site plan valid for sixty months. Authorization to Construct is valid for a period equal to that of Improvement Permit – not to exceed sixty months.

Signed: X [signature] date

Improvement Permit by: R.C. Moore date 1-27-99

Authorization to Construct by: R.C. Moore date 1-27-99

Installed by: Dale Fox

Operation Permit by: R.C. Moore date 5-25-99

Existing System Inspection by: date

HEALTH DEPT. COPY: WHITE OWNER COPY (FINAL): YELLOW OWNER COPY (INITIAL): PINK