IREDELL COUNTY HEALTH DEPARTMENT

Statesville Phone TR 3-7271 — Mooresville Phone NO 3-1271

PERMIT TO INSTALL SEPTIC TANK

Permit NO. _____ Permit Date April 16 19 64

Owner Loyde & Nancy Elder Address Northwood Acres.

Installed By C Hoke Address R7


Location of Property our Chipley Ford Rd to 3rd Rd to Right first 2nd St & R-Right next Rd 1st on L.

Tank		Capacity		Length of Lines		Fixtures	
Block	( )	800	( )	150'	( )	No. of Baths	(2)
Precast	(✓)	900	( )	175'	( )	Dishwasher	( )
		1000	(✓)	200'	( )	Garbage Grdr.	( )
		1100	( )	225'	(✓)	Auto-Washer	(✓)
		1200	( )	250'	( )	Other	
		Other		Other			

NOTIFY HEALTH DEPARTMENT AT LEAST EIGHT HOURS BEFORE TANK IS TO BE INSPECTED.

Final Inspection 4-16 19 64 Approved (✓) Disapproved ( )

Remarks well 100'. Line deep because of low plumbing and grade of land slope to house

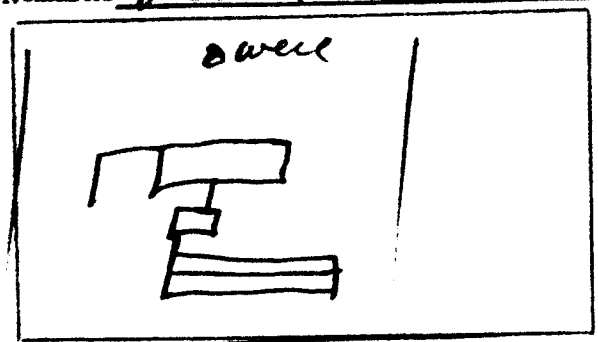

Sketch of Installation

R.L.

R.L.

Sanitarian