IREDELL COUNTY HEALTH DEPARTMENT

Statesville Phone TR 3-7271 Mooresville Phone No. 664-5281

PERMIT TO INSTALL SEPTIC TANK

Permit No. _____ Permit Date 2-11 1973

Owner Clyde Moore Address Statesville, N.C.

Installed By Lawrence Pearson Address Statesville, N.C.


Location of Property Chipley Ford Rd. Rt. on Rd. #1976 to Dead End - Turn Left 2nd Trailer on Left

Tank		Capacity		Length of Lines		Fixtures	
Block	( )	1000	(✓)	225'	(✓)	No. of Baths	(1½)
Precast	(✓)	1250	( )	250'	( )	Dishwasher	( )
		1500	( )	Other _____		Garbage Grdr.	( )
		Other _____				Other _____	

NOTIFY HEALTH DEPARTMENT AT LEAST EIGHT HOURS BEFORE TANK IS TO BE INSPECTED.

Final Inspection 2-11 1973 Approved (✓) Disapproved ( )

Remarks _____

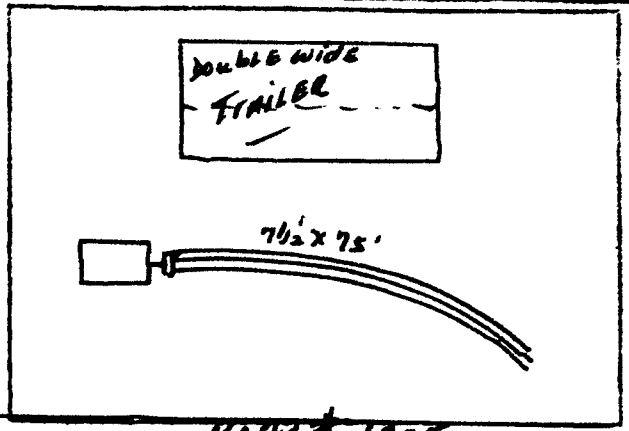

Sketch of Installation

RAH # 1975

Sanitarian