IREDELL COUNTY HEALTH DEPARTMENT

Statesville Phone TR 3-7271 Mooresville Phone No. 664-5281

PERMIT TO INSTALL SEPTIC TANK

Permit No. _____ Permit Date 5-21 1973

Owner ALLEN LADISH Address STATESVILLE, N.C.

Installed By LACKEY Bros Address Stony Point, N.C.


Location of Property 21-N-LEFT ON SHOEMAKER-THEN LEFT ON NIXON Rd. 60 ½ MILE House on Rt.

Tank		Capacity		Length of Lines		Fixtures	
Block	( )	1000	(✓)	225'	( )	No. of Baths	(1½
Precast	(✓)	1250	( )	250'	( )	Dishwasher	(✓)
		1500	( )	Other 240		Garbage Grdr.	( )
		Other				Other	

NOTIFY HEALTH DEPARTMENT AT LEAST EIGHT HOURS BEFORE TANK IS TO BE INSPECTED.

Final Inspection 5-24 1973 Approved (✓) Disapproved ( )

Remarks IREDELL WATER Corp.

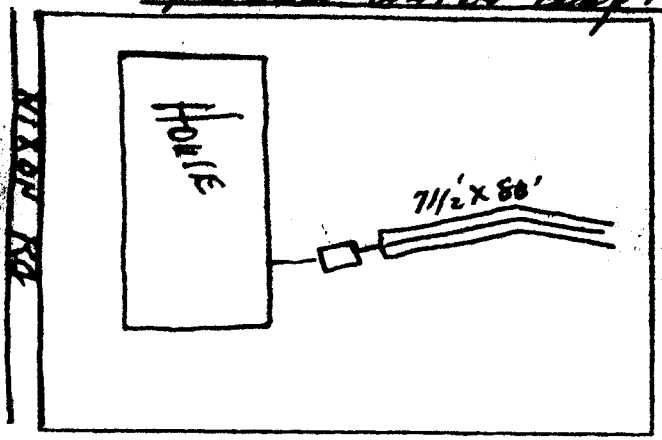

Sketch of Installation

Glenn Fox Jr.
Sanitarian