IREDELL COUNTY HEALTH DEPARTMENT

STATESVILLE 704-878-5305 MOORESVILLE 704-664-5281

IMPROVEMENT PERMIT / CERTIFICATE OF COMPLETION / OPERATION PERMIT / EXISTING SYSTEM INSPECTION

PROPERTY DESCRIPTION NO. 16476 DATE 6/9/93 TAX MAP NO 10M-A-12

OWNER OR CONTRACTOR RICHARD DIX PHONE: Business Home 876-4307

ADDRESS LOT 12, RT 11, CLOER ROAD

LOCATION NC 115 N, TR CLOER RD, TR LOT WEST WINDS DRIVE (MHP), LAST LOT ON (L)

SUBDIVISION WEST WINDS MHP BLOCK / SECTION LOT 38 LOT AREA LIMITED SITE CLASS PS L T A R

Water Supply: ☐ Individual ☑ Community ☐ Public

Septic Tank: EXISTING Gallons; STB Date

Pump Tank: Gallons; PT Date

Nitrification Field: No Fields 1 Square Feet EXISTING

No Lines 3 Trench Width Trench Depth Gravel Depth

☐ New System ☐ Repair System Type: I, II, III, IV, V, VI

System Description: CONV, GRAVITY

Repair System Description:

Maintenance Agreement Required: ☐ Yes ~~☑ No~~

House/Mod Home ☑ Mobile Home Business Other

No Bedrooms 3 No Bathrooms 2 No Employees

Slab ~~☑ Crawl~~ Space ☐ Basement w/plumbing ☐ Basement wo/plumbing

Garbage Disposal: ☐ Yes ~~☑ No~~


Auto. Dishwasher: ~~☑ Yes~~ ☐ No

Auto. Washing Machine: ☑ Yes ☐ No


Other

Comments KEEP MH MINIMUM 5' FROM SYSTEM

INITIAL SITE SKETCH

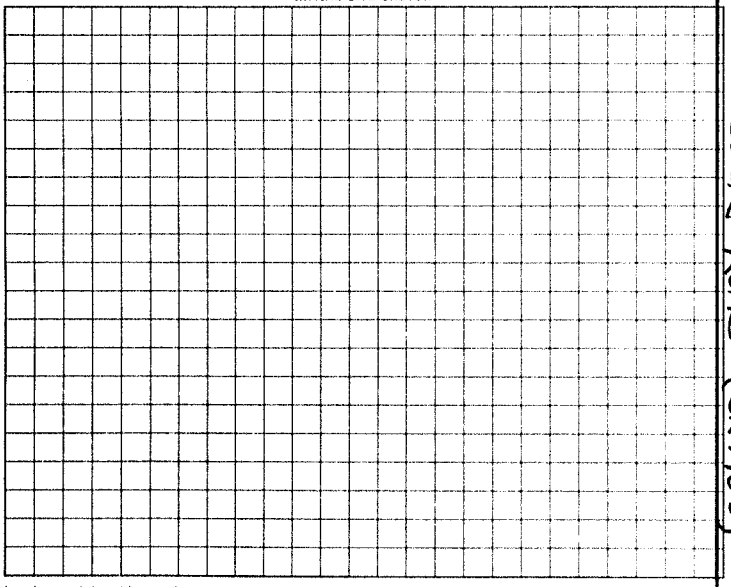

AS BUILT SKETCH

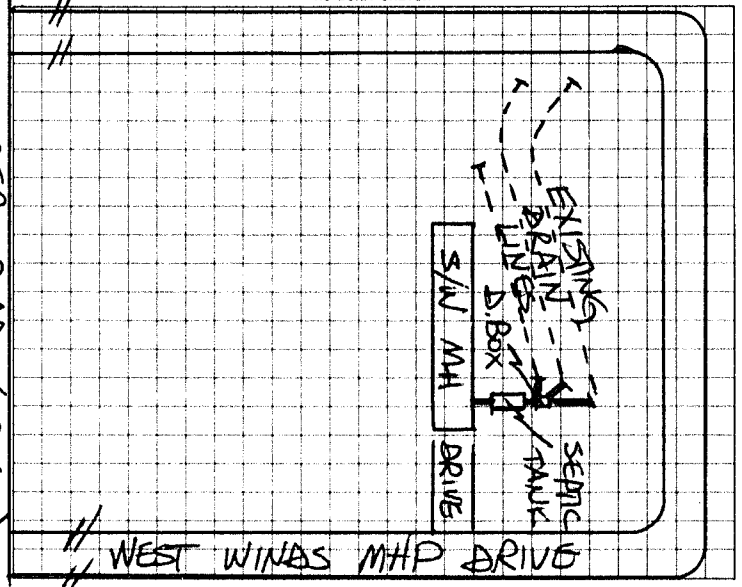

I understand that this permit can be suspended or revoked if any false information is supplied toward securing the permit/any unauthorized changes are made to the site/any unauthorized changes are made in the installation of the system. Improvement Permit is valid for 60 months from date of issuance.

Signed:

Improvement Permit by: date

Existing System Inspection by: STEVE HEDRICK date 6/9/93

Installed by

Certificate of Completion by date

Operation Permit by date

HEALTH DEPT. COPY: WHITE INSPECTION COPY (FINAL) GREEN OWNER COPY (FINAL) YELLOW INSPECTION COPY (INITIAL) PINK OWNER COPY (INITIAL) GOLD