IREDELL COUNTY HEALTH DEPARTMENT

STATESVILLE 704-878-5305 MOORESVILLE 704-664-5281

IMPROVEMENT PERMIT / CERTIFICATE OF COMPLETION / OPERATION PERMIT / EXISTING SYSTEM INSPECTION

PROPERTY DESCRIPTION NO. 21769 DATE 8-1-95 TAX MAP NO. 10M-A-12 Watershed: ☐ Yes ☑ No

OWNER OR CONTRACTOR Richard Dix PHONE: Business _____ Home 876-4307

ADDRESS 151 Westwinds Loop Statesville, N.C. 28677

LOCATION Hwy 115 N TR Branchwood Rd. TR Westwinds Loop Last lot in center

SUBDIVISION Westwinds MHP BLOCK / SECTION - LOT 38 LOT AREA - SITE CLASS Existing DESIGN FLOW 360 L.T.A.R. Existing .4 gpd/ft²

Septic Tank: _____ Gallons; STB _____ Date _____
Pump Tank: Existing Gallons; PT _____ Date _____
Pump Make: _____ Model System Serial No. _____
Nitrification Field: No Fields ____ Square Feet _____ Linear Feet Inspection
No Lines _____ Trench Width _____ Max Trench Bottom Depth _____ Gravel Depth _____

☐ New System ☐ Repair System Type: I. II. III. IV. V. VI
System Description: Existing System
Repair System Description: Inspection
Maintenance Agreement Required: ☐ Yes ☐ No

☐ House/Mod. Home No. Bedrooms 3
☑ Mobile Home No. Bathrooms 2
☐ Business No. Employees ____
☐ Other _____
☐ Slab ☑ Crawl Space ☐ Basement w/plumbing ☐ Basement wo/plumbing


Water Supply:
☐ Individual
☐ Community
☑ Public

Comments:

Comments: Home vacant for period of time. System shows no visible signs of malfuction at time of inspection. Home to be located in same spot as prior MH. Keep home min. 5' from any part of septic System.

INITIAL SITE SKETCH

AS BUILT SKETCH

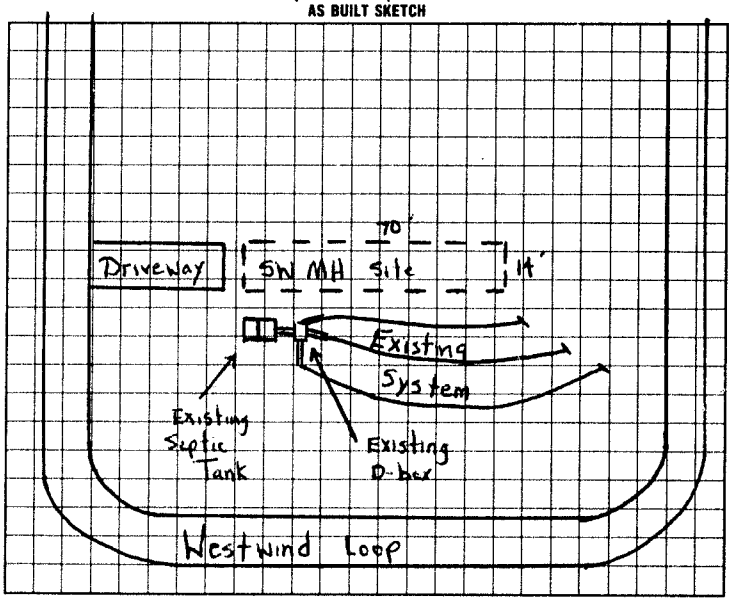

I understand that this permit can be suspended or revoked if any false information is supplied toward securing the permit/any unauthorized changes are made to the site/any unauthorized changes are made in the installation of the system.

Signed: _____ Installed by: _____

Improvement Permit by: _____ date _____ Certificate of Completion by: _____ date _____

Existing System Inspection by: Richard J. Denman date 8-1-95 Operation Permit by: _____ date _____

HEALTH DEPT. COPY: WHITE INSPECTION COPY (FINAL): GREEN OWNER COPY (FINAL): YELLOW INSPECTION COPY (INITIAL): PINK OWNER COPY (INITIAL): GOLD