IREDELL COUNTY HEALTH DEPARTMENT

STATESVILLE 704-878-5305 MOORESVILLE 704-664-5281

IMPROVEMENT PERMIT / CERTIFICATE OF COMPLETION / OPERATION PERMIT / EXISTING SYSTEM INSPECTION

PROPERTY DESCRIPTION NO. 16477 DATE 6/9/93 TAX MAP NO. 10M-A-12

OWNER OR CONTRACTOR RICHARD DIX PHONE, Business Home 876-4307

ADDRESS LOT 12, RT 11, CLOER ROAD, STATESVILLE NC 28677

LOCATION NC 115 N, TR CLOER RD, TR 1ST WEST WINDS DRIVE 18TH LOT ON (R)

SUBDIVISION WEST WINDS MHP BLOCK / SECTION LOT 20 LOT AREA LIMITED SITE CLASS P3 L.T.A.R.

Water Supply: ☐ Individual ☑ Community ☐ Public

Septic Tank: EXISTING Gallons: STB Date

Pump Tank: Gallons: PT Date

Nitrification Field: No Fields 1 Square Feet EXISTING Other Feet

No Lines 2 Trench Width Trench Depth Gravel Depth

☐ New System ☐ Repair System Type: I, II, III, IV, V, VI

System Description: CONV, GRAVITY

Repair System Description:

Maintenance Agreement Required: ☐ Yes ☑ No

☐ House/Mod. Home ☑ Mobile Home ☐ Business ☐ Other

No. Bedrooms 3 No. Bathrooms 2 No. Employees


Garbage Disposal: ☐ Yes ☑ No Auto. Dishwasher: ☑ Yes ☐ No Auto. Washing Machine: ☑ Yes ☐ No Other

☐ Slab ☑ Crawl Space ☐ Basement w/plumbing ☐ Basement wo/plumbing

Comments KEEP MH MINIMUM 5' FROM SYSTEM

INITIAL SITE SKETCH

AS BUILT SKETCH

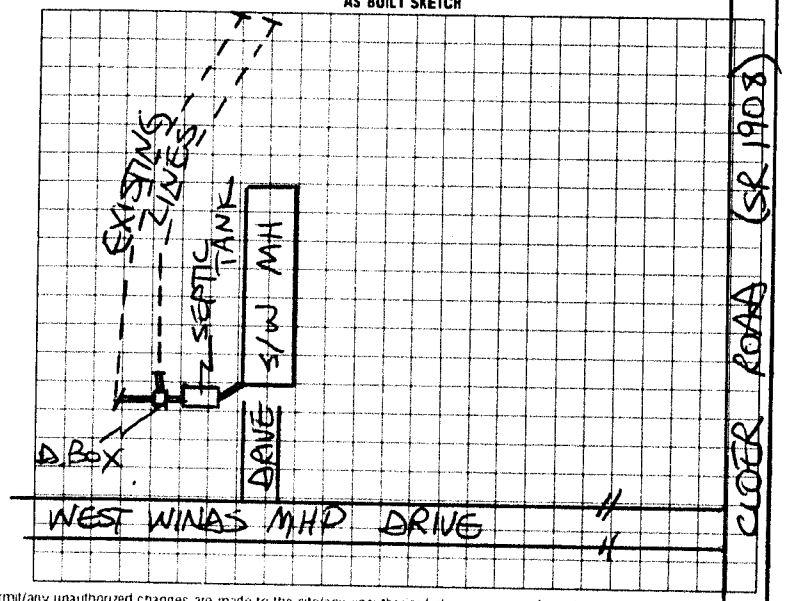

I understand that this permit can be suspended or revoked if any false information is supplied toward securing the permit/any unauthorized changes are made to the site/any unauthorized changes are made in the installation of the system. Improvement Permit is valid for 60 months from date of issuance.

Signed:

Improvement Permit by: date

Existing System Inspection by: STEVE HEDRICK date 6/9/93

Installed by

Certificate of Completion by date

Operation Permit by date

HEALTH DEPT COPY: WHITE INSPECTION COPY (FINAL): GREEN OWNER COPY (FINAL): YELLOW INSPECTION COPY (INITIAL): PINK OWNER COPY (INITIAL): GOLD