IREDELL COUNTY HEALTH DEPARTMENT

STATESVILLE 704-878-5305 MOORESVILLE 704-664-5281

IMPROVEMENT PERMIT / AUTHORIZATION TO CONSTRUCT / OPERATION PERMIT / EXISTING SYSTEM INSPECTION

PERMIT# 103121 PIN# 4737-08-0729 DATE 10-31-01

OWNER OR CONTRACTOR WILLIAM (BILL) CARTER PHONE: Business (704) 883-8228 Home

ADDRESS 201 WEST BROAD STREET, STATESVILLE NC 28625

LOCATION NC 115 N, TR BRANCHWOOD RD, TR 1 WESTWINDS LOOP, 9TH MH ON RIGHT

SUBDIVISION WESTWINDS MHP BLOCK / SECTION LOT 175 LOT AREA LIMITED SITE CLASS PS DESIGN FLOW 240 L.T.A.R. EXISTING

Septic Tank: 1000 Gallons: ST Date

Pump Tank: Gallons: PT Date

Pump Make: Model Serial No

Nitrification Field: No Fields 1 Square Feet Linear Feet 240

No Lines THREE Trench Width Max Trench Bottom Depth 36" Gravel Depth 12"

☐ New System ☐ Repair System Type: I II III IV V VI

System Description: CONVENTIONAL GRAVITY

Repair System Description:

Maintenance Agreement Required: ☐ Yes ☑ No

☐ House/Mod. Home ☑ Mobile Home ☐ Business ☐ Other

No. Bedrooms 2 No. Bathrooms 2 No. Employees

☐ Slab ☑ Crawl Space ☐ Basement w/plumbing ☐ Basement wo/plumbing

Water Supply: ☐ Individual ☑ Public ☑ Community


Comments/Conditions:

Comments/Conditions SYSTEM UNDERSIZED ACCORDING TO TODAY'S STANDARDS

BRANCHWOOD ROAD (SR 1908)

INITIAL SITE SKETCH

AS BUILT SKETCH

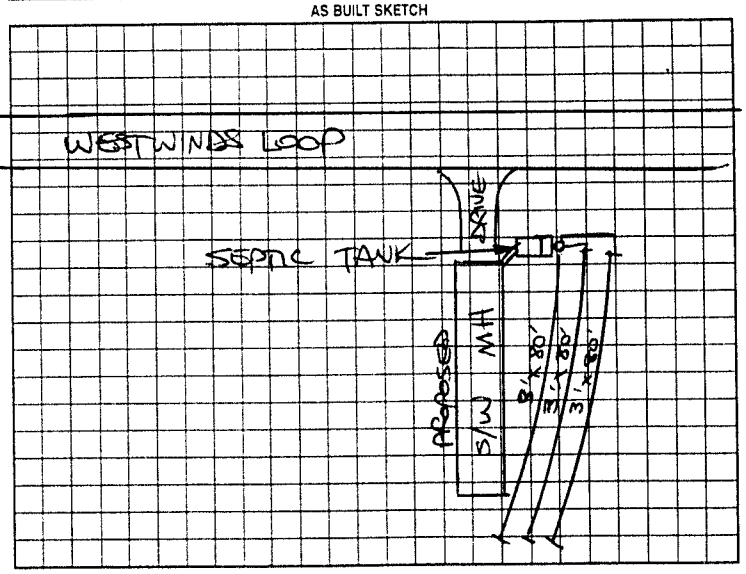

Permit can be suspended or revoked if any false information is supplied toward securing the permit/any unauthorized changes are made to the site/any unauthorized changes are made in the installation of the system. Improvement Permit with plat valid without expiration. Improvement Permit with site plan valid for sixty months. Authorization to Construct is valid for a period equal to that of Improvement Permit – not to exceed sixty months.

Signed: date

Improvement Permit by: date

Authorization to Construct by: date

Installed by:

Operation Permit by: date

Existing System Inspection by: STEVE HENRICK date 10-31-01

HEALTH DEPT COPY: WHITE OWNER COPY (FINAL): YELLOW OWNER COPY (INITIAL): PINK