IREDELL COUNTY HEALTH DEPARTMENT

STATESVILLE 704-878-5305 MOORESVILLE 704-664-5281

IMPROVEMENT PERMIT / CERTIFICATE OF COMPLETION / OPERATION PERMIT / EXISTING SYSTEM INSPECTION

PROPERTY DESCRIPTION NO. 23086 DATE 1-31-96 TAX MAP NO 10M-A-12 Watershed: Yes ✓ No

OWNER OR CONTRACTOR RICHARD & JOAN DIX PHONE Business Home 876-4307

ADDRESS 151 WESTWINDS LOOP STVL NC 28677

LOCATION NC115 N, TR BRANCHWOOD, TR 1ST WESTWINDS LOOP, 5TH MH LOT ON LEFT

SUBDIVISION WESTWINDS BLOCK / SECTION #178 LOT 39 LOT AREA LIMITED SITE CLASS PSI DESIGN FLOW 360 LTAR EXISTING

Septic Tank: 1000 Gallons; STB Date

Pump Tank: Gallons; PT Date

Pump Make: Model Serial No

Nitrification Field: No Fields Square Feet Linear Feet 240

No Lines 3 Trench Width Max Trench Bottom Depth

New System Repair System Type CONV. I II III IV V

System Description CONV. GRAVITY

Repair System Description

Maintenance Agreement Required Yes ✓ No

Gravel Depth

Slab ✓ Crawl Space Basement w/plumbing Basement wo/plumbing

House/Mod Home No Bedrooms 3

✓ Mobile Home No Bathrooms 2

Business No Employees

Other

Water Supply

Individual


✓ Community

✓ Public

Comments:

Comments KEEP MH MINIMUM 5' FROM SYSTEM

~~INITIAL SITE SKETCH~~

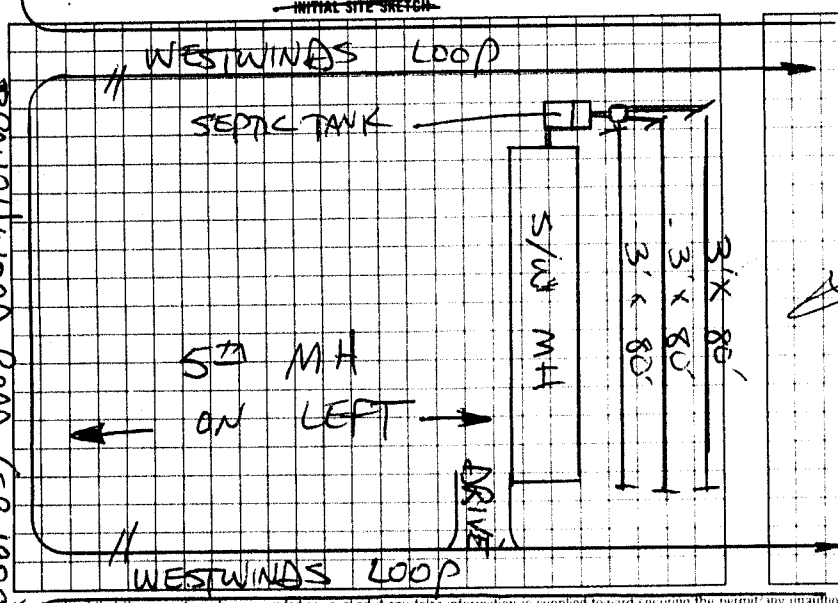

AS BUILT SKETCH

I understand that this permit can be suspended or revoked if any false information is supplied toward securing the permit/any unauthorized changes are made to the site/any unauthorized changes are made in the installation of the system

Signed

Improvement Permit by date

Existing System Inspection by STEVE HERRICK date 1-31-96

Installed by

Certificate of Completion by date

Operation Permit by date

HEALTH DEPT COPY WHITE INSPECTION COPY (FINAL) GREEN OWNER COPY (FINAL) YELLOW INSPECTION COPY (INITIAL) PINK OWNER COPY (INITIAL) GOLD