IREDELL COUNTY HEALTH DEPARTMENT

STATESVILLE 704-878-5305 MOORESVILLE 704-664-5281

IMPROVEMENT PERMIT / AUTHORIZATION TO CONSTRUCT / OPERATION PERMIT / EXISTING SYSTEM INSPECTION

PERMIT# Repair PIN# 4737-08-0729 DATE 2/3/03

OWNER OR CONTRACTOR Bill Carter PHONE: Business (704) 450-9999 Home —

ADDRESS P.O. Box 606 Statesville, N.C. 2867

LOCATION Hwy 115 N. (Rear) Brookwood Dr on Wetland Loop at bottom of hill Lot #17

SUBDIVISION Wetland mtf/ BLOCK / SECTION — LOT 17 LOT AREA — SITE CLASS. 05 DESIGN FLOW — L.T.A.R. .25

Septic Tank: — Gallons; STB — Date —
Pump Tank: — Gallons; P.T. — Date —
Pump Make: — Model — Serial No. —
~~Nitrification Field: No Fields — Square Feet — Linear Feet~~
No Lines 10 @ 40' Trench Width 36" Max Trench Bottom Depth 30" Gravel Depth 16"

☐ New System ☐ Repair System Type: I, II, III, IV, V, VI
System Description:
Repair System Description:
Maintenance Agreement Required: ☐ Yes ☐ No

☐ House/Mod. Home No. Bedrooms
☐ Mobile Home No. Bathrooms
☐ Business No. Employees
☐ Other
☐ Slab ☐ Crawl Space ☐ Basement w/plumbing ☐ Basement wo/plumbing


Water Supply:
☐ Individual
☐ Public
☐ Community

Comments:/Conditions:

- Disposal of undersize gravel from repair of Lot # House # 181.

Comments:/Conditions:

INITIAL SITE SKETCH Not to scale

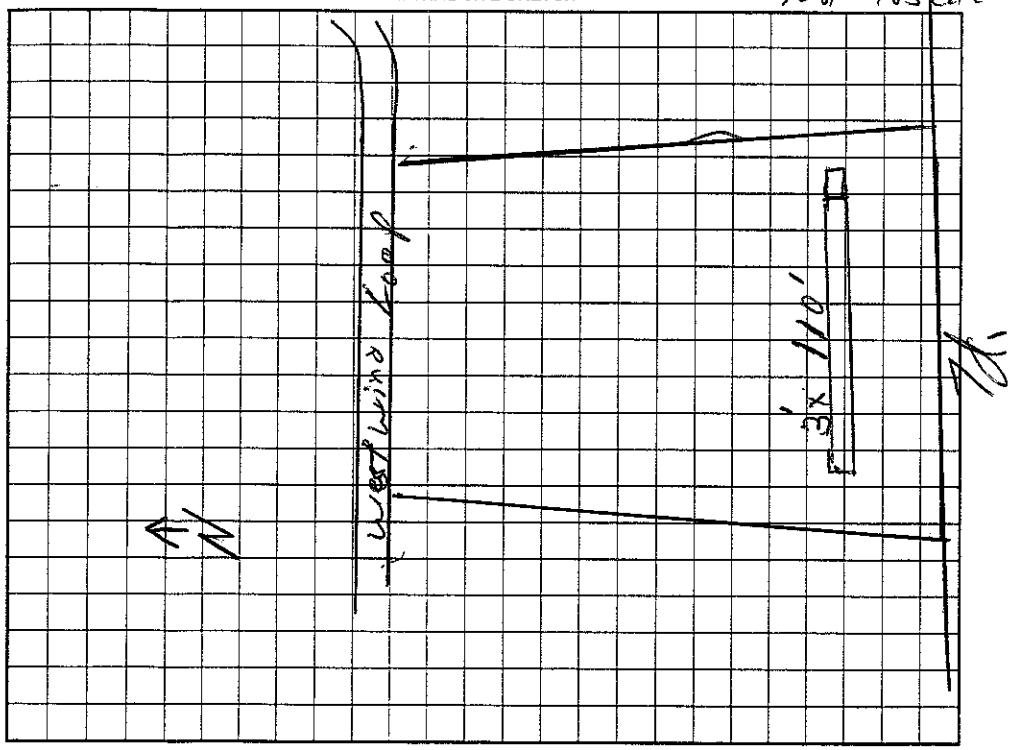

AS BUILT SKETCH

disposed of
According to
Sketch

Permit can be suspended or revoked if any false information is supplied toward securing the permit/any unauthorized changes are made to the site/any unauthorized changes are made in the installation of the system. Improvement Permit with plat valid without expiration. Improvement Permit with site plan valid for sixty months. Authorization to Construct is valid for a period equal to that of Improvement Permit – not to exceed sixty months.

Signed: William Ray Carter date 2-3-03 Installed by: Bill Carter

Improvement Permit by: — date — Operation Permit by: William O. Johnson date 3/5/03

Authorization to Construct by: — date — Existing System Inspection by: — date —

HEALTH DEPT. COPY: WHITE OWNER COPY (FINAL): YELLOW OWNER COPY (INITIAL): PINK