IREDELL COUNTY HEALTH DEPARTMENT

THIS PERMIT VOIDS PREVIOUS ISSUED 3-3-97

STATESVILLE 704-878-5305 MOORESVILLE 704-664-5281

IMPROVEMENT PERMIT / AUTHORIZATION TO CONSTRUCT / OPERATION PERMIT / EXISTING SYSTEM INSPECTION

PERMIT# 25978 PIN# 4738 00 6849 DATE 3-16-98

OWNER OR CONTRACTOR CRAVEN, KEARNS, McDOWELL PHONE: Business (910) 672-2264 Home

ADDRESS P.O. BOX 2257, ASHEBORO, NC 27204

LOCATION NC 115 N, TR BRANCHWOOD ROAD, 5TH LOT ON RIGHT PAST HANGING TREE LANE

SUBDIVISION RIDGECREST BLOCK / SECTION 1 LOT 5 LOT AREA 0.713 ACRE SITE CLASS. PS DESIGN FLOW 360 L.T.A.R. 0.30 GPD/FT²

Septic Tank: 1000 Gallons; STB ~~620~~ 620 Date 2-19-98

Pump Tank: _____ Gallons; PT _____ Date _____

Pump Make: _____ Model _____ Serial No. _____

Nitrification Field: No Fields 1 Square Feet ~~EQ. TO~~ 1200 Linear Feet 300+

No Lines FIVE Trench Width 36" Max Trench Bottom Depth 36" ~~Gravel~~ Depth SAND 6"

☑ New System ☐ Repair System Type: I II III IV V VI

System Description: CHAMBERED GRAVITY CONV. PUMP

Repair System Description: _____

Maintenance Agreement Required: ☐ Yes ☑ No

☐ House/Mod. Home ☑ Mobile Home ☐ Business ☐ Other

No. Bedrooms 3 No. Bathrooms 2 No. Employees _____


☐ Slab ☑ Crawl Space ☐ Basement w/plumbing ☐ Basement wo/plumbing

Water Supply: ☐ Individual ☑ Public ☐ Community


Comments:/Conditions: INSTALL FIFTY CHAMBERS IN FIVE EQUAL LENGTH LINES AS FLAGGED ON SITE USING TWO DISTRIBUTION BOXES AS SHOWN

Comments:/Conditions: Note Tank sits directly behind Trailer at corner

INITIAL SITE SKETCH

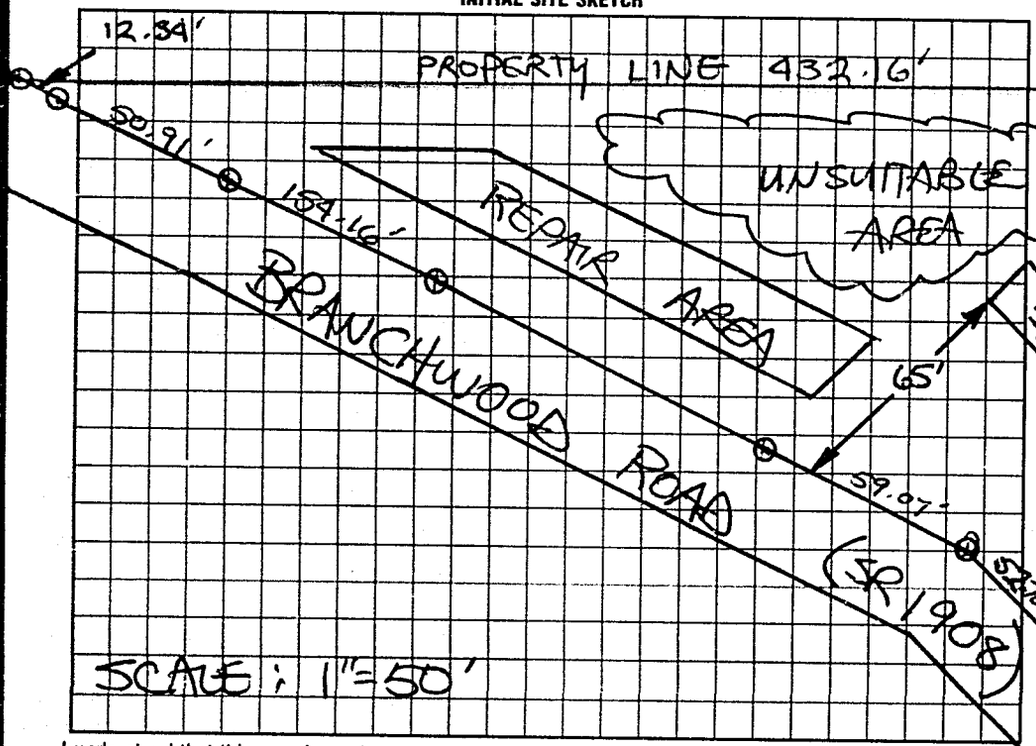

AS BUILT SKETCH

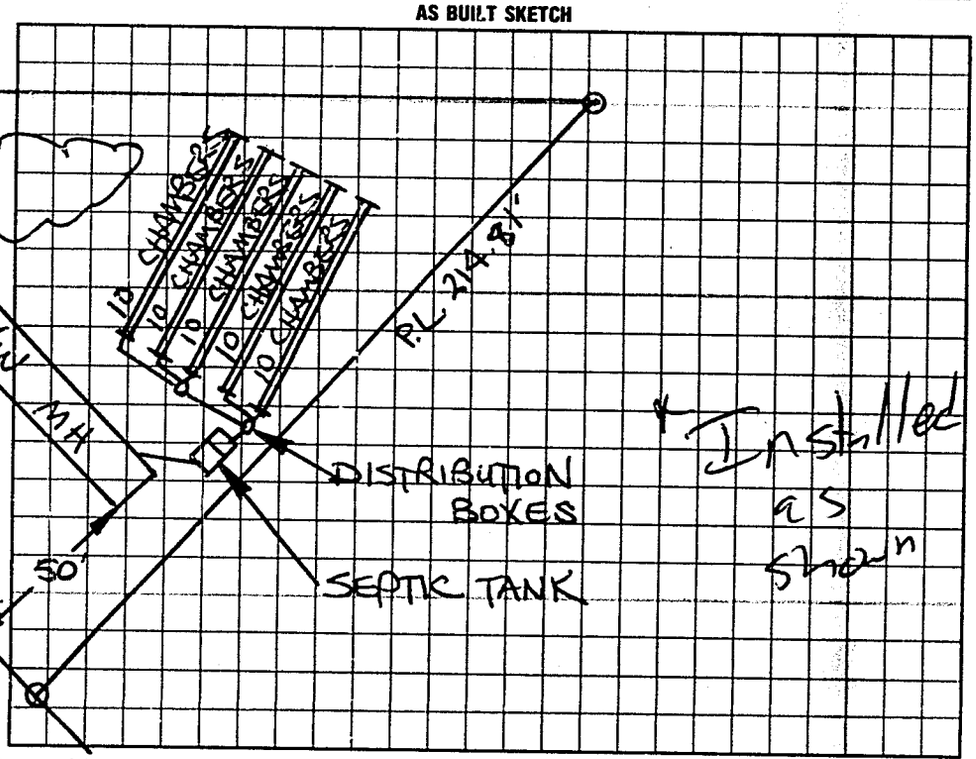

I understand that this permit can be suspended or revoked if any false information is supplied toward securing the permit/any unauthorized changes are made to the site/any unauthorized changes are made in the installation of the system. Improvement Permit with plat valid without expiration. Improvement Permit with site plan valid for sixty months. Authorization to Construct is valid for a period equal to that of Improvement Permit – not to exceed sixty months.

Signed: _____ date _____

Improvement Permit by: STEVE HEDRICK date 3-16-98

Authorization to Construct by: STEVE HEDRICK date 3-16-98

Installed by: Sammy Davis

Operation Permit by: Mary Coffey date 4-3-98

Existing System Inspection by _____ date _____

HEALTH DEPT COPY WHITE INSPECTION COPY (FINAL) GREEN OWNER COPY (FINAL) YELLOW INSPECTION COPY (INITIAL) PINK OWNER COPY (INITIAL) GOLD

92 0 00