47484 ~~47196~~

# IREDELL COUNTY HEALTH DEPARTMENT

STATESVILLE 704-878-5305 MOORESVILLE 704-664-5281

## IMPROVEMENT PERMIT / CERTIFICATE OF COMPLETION / OPERATION PERMIT / EXISTING SYSTEM INSPECTION

PROPERTY DESCRIPTION NO. 16227 DATE 7/21/93 TAX MAP NO. 10M-A-10

OWNER OR CONTRACTOR CARL H. KRUMROY PHONE: Business _____ Home _____

ADDRESS _____

LOCATION NC115N, TR CLOER RD, 1ST DRIVEWAY ON (R) AFTER PAVEMENT END, BACK OFF ROAD

SUBDIVISION _____ BLOCK / SECTION _____ LOT _____ LOT AREA 35 ACRES SITE CLASS. PS L.T.A.R. 0.40 GPD/FT²

Water Supply: ☑ Individual ☐ Community ☐ Public WELL

Septic Tank: 1500 Gallons; STB 1011 Date 4/25/93

Pump Tank: _____ Gallons; PT _____ Date _____

Nitrification Field: No Fields 1 Square Feet 900 Linear Feet 300

No Lines 4 Trench Width 36" Trench Depth 24" Gravel Depth 12"

☑ New System ☐ Repair System Type: I, II, III, IV, V, VI

System Description: CONV. GRAVITY

Repair-System Description: CONV. GRAVITY

Maintenance Agreement Required: ☐ Yes ☑ No

☐ House/Mod. Home No. Bedrooms 3

☐ Mobile Home No. Bathrooms 2

☐ Business No. Employees _____

☐ Other _____

Garbage Disposal: ☑ Yes ☐ No

Auto. Dishwasher: ☑ Yes ☐ No


Auto. Washing Machine: ☑ Yes ☐ No

Other _____


~~☐ Slab~~ ~~☐ Crawl Space~~ ☐ Basement w/plumbing ☐ Basement wo/plumbing

Comments _____

INITIAL SITE SKETCH

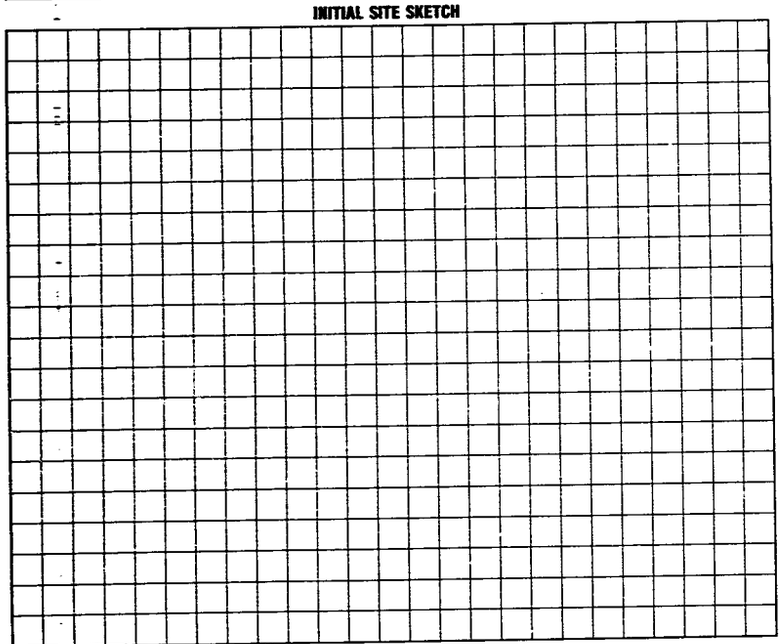

AS BUILT SKETCH

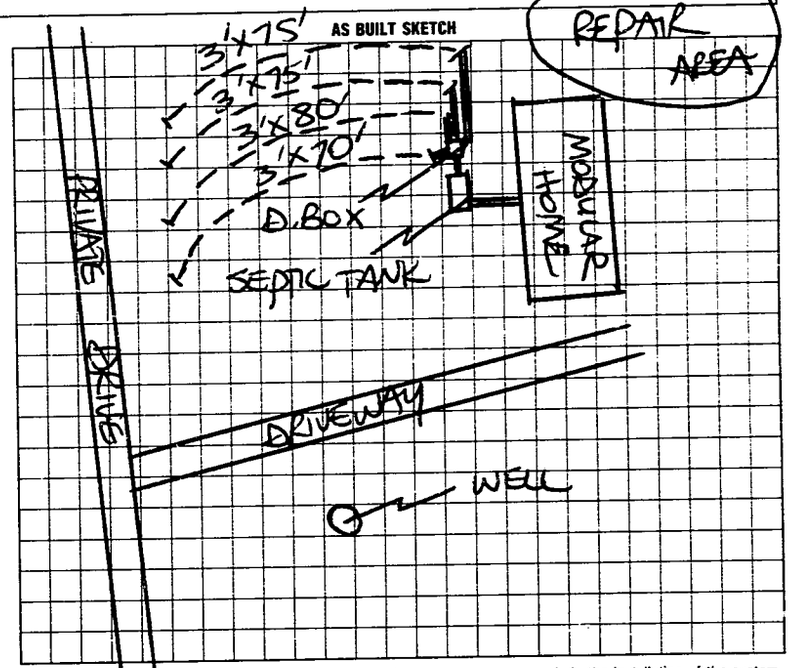


I understand that this permit can be suspended or revoked if any false information is supplied toward securing the permit/any unauthorized changes are made to the site/any unauthorized changes are made in the installation of the system. Improvement Permit is valid for 60 months from date of issuance.

Signed: _____ 4/28/93

Improvement Permit by: STEVE HEDRICK date 16227

Existing System Inspection by: _____ date _____

Installed by: KENNY PEARSON

Certificate of Completion by: STEVE HEDRICK date 7/21/93

Operation Permit by: _____ date _____

HEALTH DEPT. COPY: WHITE INSPECTION COPY (FINAL): GREEN OWNER COPY (FINAL): YELLOW INSPECTION COPY (INITIAL): PINK OWNER COPY (INITIAL): GOLD