IREDELL COUNTY HEALTH DEPARTMENT

STATESVILLE 704-878-5305 MOORESVILLE 704-664-5281

IMPROVEMENT PERMIT / AUTHORIZATION TO CONSTRUCT / OPERATION PERMIT / EXISTING SYSTEM INSPECTION

PERMIT# 80644 PIN# 4737721 3788 DATE 4-30-99

OWNER OR CONTRACTOR Erica Weston PHONE: Business Home 876-4647

ADDRESS 2829 S. Chipley Ford Rd Statesville, N.C.

LOCATION 115N TR pst chimney Rd TR Chipley Ford TR behind Jeff's Truck & Tractor

SUBDIVISION BLOCK / SECTION LOT 8 LOT AREA acres SITE CLASS. PS DESIGN FLOW 360 L.T.A.R. .3

Septic Tank: 1000 Gallons; STB 312 Date 4-31-99
Pump Tank: Gallons; PT Date
Pump Make: Model Serial No.
Nitrification Field: No Fields 1 Square Feet 1200 Linear Feet 400
No Lines 3 Trench Width 36" Max Trench Bottom Depth 36" Gravel Depth 12"

☑ New System ☐ Repair System Type: I II III IV V VI
System Description: Conv. Gravity
Repair System Description:
Maintenance Agreement Required: ☐ Yes ☑ No


☑ House/Mod. Home No. Bedrooms 3
☐ Mobile Home No. Bathrooms 2
☐ Business No. Employees
☐ Other
☐ Slab ☑ Crawl Space ☐ Basement w/plumbing ☐ Basement wo/plumbing

Water Supply:
☐ Individual
☐ Public (2 Community)


Comments/Conditions:

Comments/Conditions:
Installed as shown

INITIAL SITE SKETCH

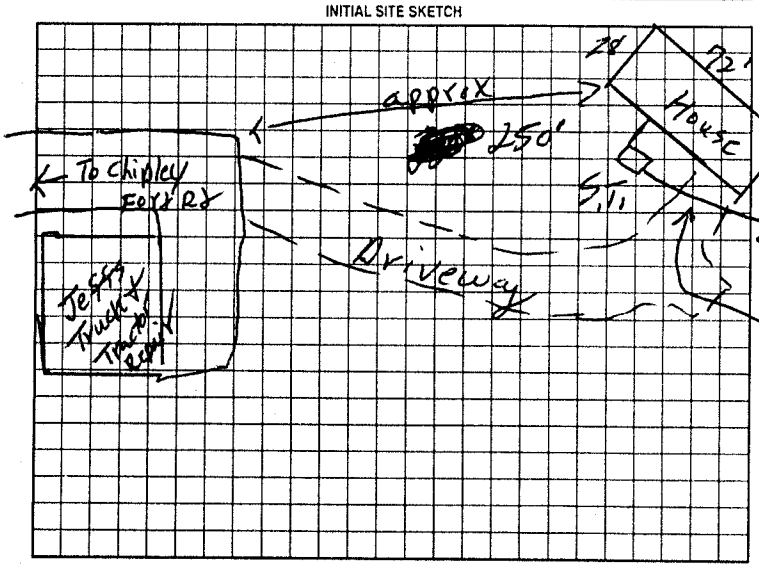

AS BUILT SKETCH

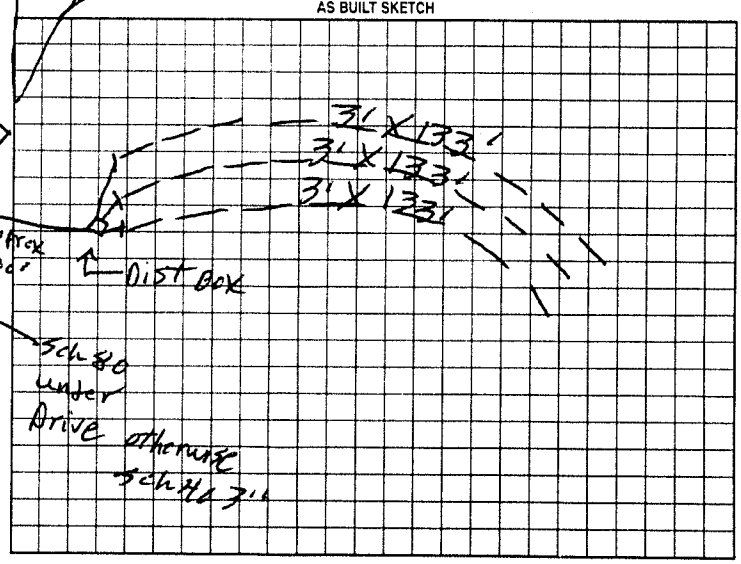

Permit can be suspended or revoked if any false information is supplied toward securing the permit/any unauthorized changes are made to the site/any unauthorized changes are made in the installation of the system. Improvement Permit with plat valid without expiration. Improvement Permit with site plan valid for sixty months. Authorization to Construct is valid for a period equal to that of Improvement Permit -- not to exceed sixty months.

Signed: x R. Makepeace date

Improvement Permit by: L. C. Moore date 4-30-99

Authorization to Construct by: L. C. Moore date 4-30-99

Installed by: James Hyder

Operation Permit by: [illegible] date 8-2-99

Existing System Inspection by: date

HEALTH DEPT COPY: WHITE OWNER COPY (FINAL): YELLOW OWNER COPY (INITIAL): PINK