This permit voids previously issued permit dated 8-13-03

IREDELL COUNTY HEALTH DEPARTMENT

STATESVILLE 704-878-5305 CI MOORESVILLE 704-664-5281

IMPROVEMENT PERMIT / AUTHORIZATION TO CONSTRUCT / OPERATION PERMIT / EXISTING SYSTEM INSPECTION

PERMIT# 101474 PIN# ~~4737-23-5364.04~~ 4737-23-5304 DATE

OWNER OR CONTRACTOR Crandle + O'Brien Construction Co. PHONE: Business (704) 871-1536 Home

ADDRESS 370 Tree bark Rd. Statesville N.C. 28625

LOCATION Chipley Ford Rd (N), (L) Chimney Ridge - at End on Left

SUBDIVISION Chimney Ridge BLOCK / SECTION — LOT 6 LOT AREA 1.5 Ac SITE CLASS. P5 DESIGN FLOW 360 L.T.A.R. .25

Septic Tank: 4000 Gallons; STB 1007 Date 8-13-03
Pump Tank: Gallons; PT Date
Pump Make: Model Serial No.
Nitrification Field: No Fields 1 Square Feet ~~1440~~ Linear Feet 360
No Lines 5 Trench Width 36" Max Trench Bottom Depth 36" Gravel Depth N/A

☒ New System ☐ Repair System Type: I, II, (III), IV, V, VI
System Description: Gravity, 25% Reduction
Repair System Description: Pump, 25% Reduction
Maintenance Agreement Required: ☐ Yes ☐ No

☒ House/Mod. Home ☐ Mobile Home ☐ Business ☐ Other
No. Bedrooms 3 No. Bathrooms 3 No. Employees


Water Supply: ☐ Individual ☒ Public ☐ Community

☐ Slab ☒ Crawl Space ☐ Basement w/plumbing ☐ Basement wo/plumbing

Comments:/Conditions: ① Install Lines on Contour

Comments:/Conditions: - Tank - Tee Filter + ST Marker Installed
- 49 Infiltrator Chambers Installed
12 top line / 13, 13, 13, 7 bottom line Chambers/Line

INITIAL SITE SKETCH 1"=50'

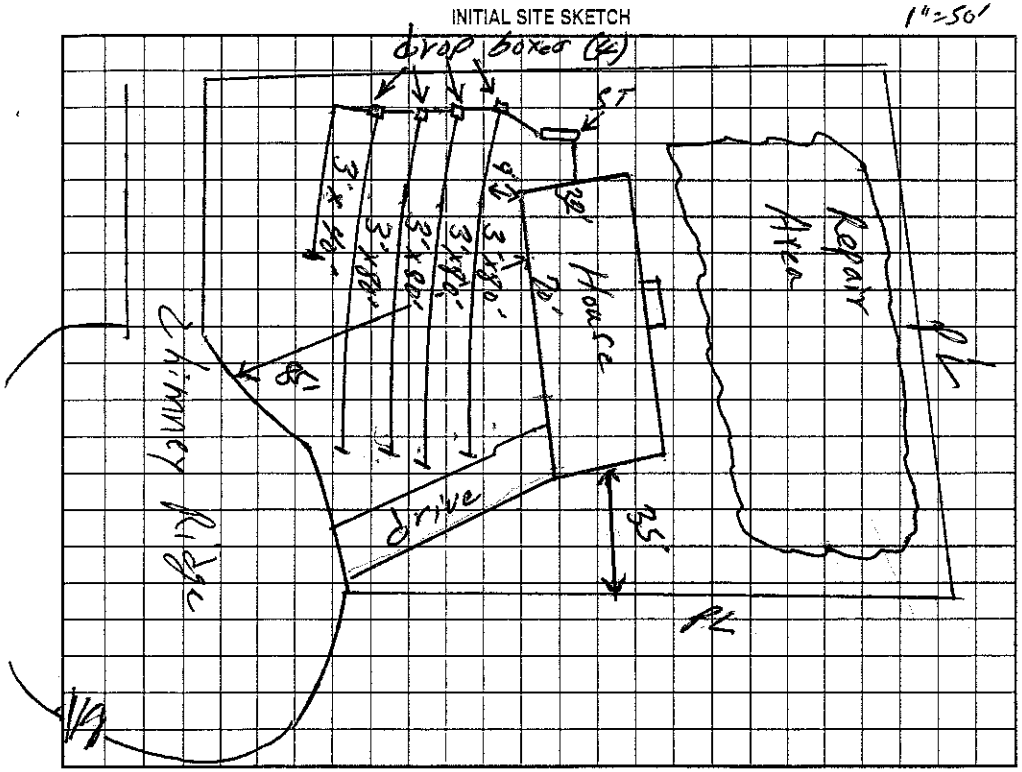

AS BUILT SKETCH

Installed As Shown Per Initial Site Sketch

Permit can be suspended or revoked if any false information is supplied toward securing the permit/any unauthorized changes are made to the site/any unauthorized changes are made in the installation of the system. Improvement Permit with plat valid without expiration. Improvement Permit with site plan valid for sixty months. Authorization to Construct is valid for a period equal to that of Improvement Permit – not to exceed sixty months.

Signed: Jack Crandell date Installed by: Bill Green

Improvement Permit by: William O. Johnson date 8/10/02 Operation Permit by: William O. Johnson date 9/29/03

Authorization to Construct by: William O. Johnson date 8/13/03 Existing System Inspection by: date

HEALTH DEPT. COPY: WHITE OWNER COPY (FINAL): YELLOW OWNER COPY (INITIAL): PINK