IREDELL COUNTY HEALTH DEPARTMENT

STATESVILLE 704-878-5305 CT MOORESVILLE 704-664-5281

IMPROVEMENT PERMIT / AUTHORIZATION TO CONSTRUCT / OPERATION PERMIT / EXISTING SYSTEM INSPECTION

PERMIT# 101469 PIN# ~~4737-23-5364.03~~ 4737-23-5519 DATE 8/10/01

OWNER OR CONTRACTOR CRANDLE & O'BRIEN CONSTRUCTION PHONE: Business 871-1536 Home

ADDRESS 310 TREEBARK RD - STATESVILLE NC 28625

LOCATION CHIPLEY FORD (N) - TL JUST PAST RED CHIMNEY ONTO CHIMNEY RIDGE - LOT AT END ON Rt

SUBDIVISION CHIMNEY RIDGE BLOCK / SECTION LOT 3 LOT AREA .515AC SITE CLASS. PS DESIGN FLOW 360GPD L.T.A.R. .25 GPD/FT2

Septic Tank: 1000 Gallons; STB 1007 Date 6-27-03
Pump Tank: Gallons; PT Date
Pump Make: Model Serial No.
Nitrification Field: No Fields 1 Square Feet 1080 Linear Feet 360
No Lines B 4@90' Trench Width 36" Max Trench Bottom Depth 36" Gravel Depth N/A

☒ New System ☐ Repair System Type: I, II, III, IV, V, VI
System Description: GRAVITY 25% REDUCTION
Repair System Description: PUMP/GRAV. SAME
Maintenance Agreement Required: ☐ Yes ☒ No

☒ House/Mod. Home No. Bedrooms 3
☐ Mobile Home No. Bathrooms 3
☐ Business No. Employees
☐ Other

☐ Slab ☒ Crawl Space ☐ Basement w/plumbing ☐ Basement wo/plumbing


Water Supply: ☐ Individual ☒ Public ☐ Community

Comments:/Conditions:


House Plans Submitted 3/27/03 - okay to move House to right

Comments:/Conditions: S.T. marker & Poly Lot Flow Installed
-58 Bio Diffuser Panels Installed
- System installed deeper than 36" due to design

INITIAL SITE SKETCH 1"=50'

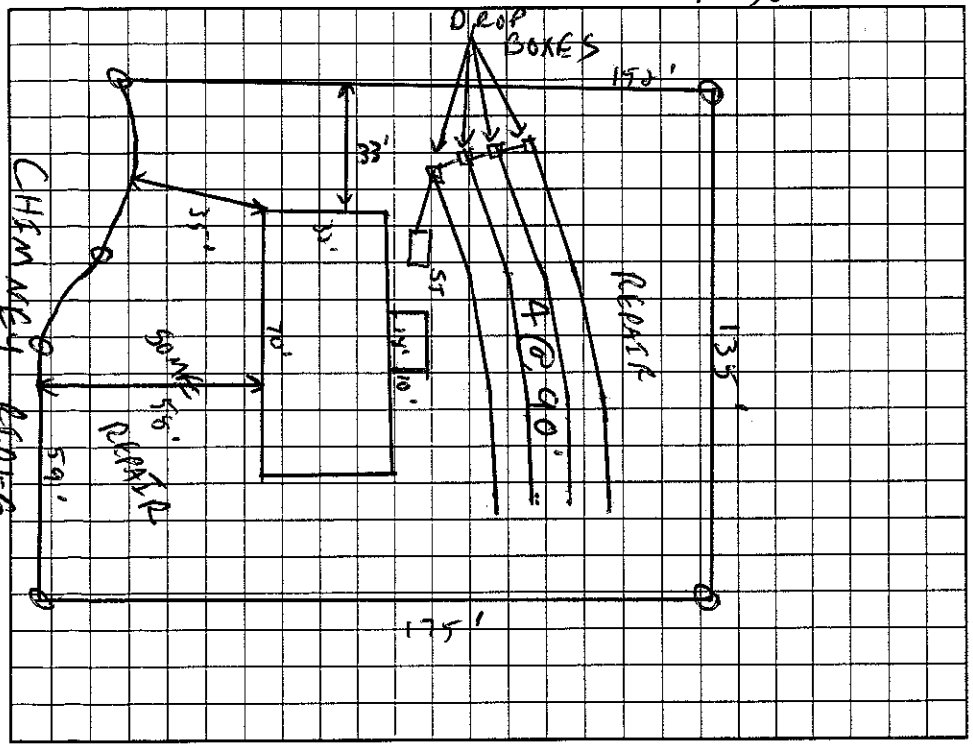

AS BUILT SKETCH

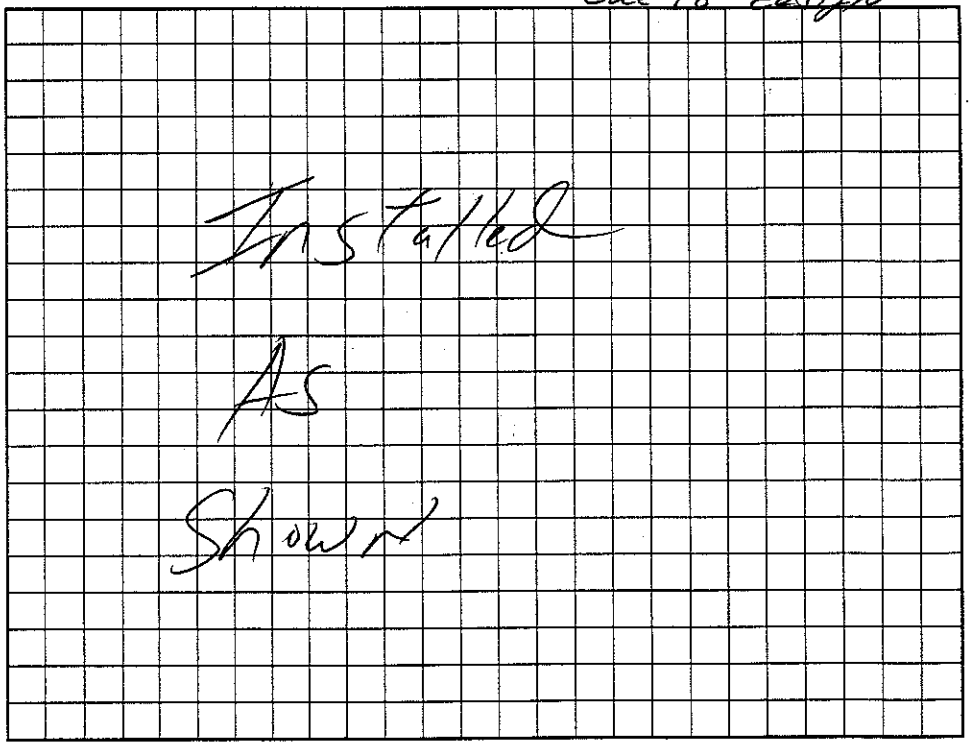

Permit can be suspended or revoked if any false information is supplied toward securing the permit/any unauthorized changes are made to the site/any unauthorized changes are made in the installation of the system. Improvement Permit with plat valid without expiration. Improvement Permit with site plan valid for sixty months. Authorization to Construct is valid for a period equal to that of Improvement Permit – not to exceed sixty months.

Signed: date

Improvement Permit by: C. Lowery KS date 8/10/01

Authorization to Construct by: date 3/27/03

Installed by: Bill Greene

Operation Permit by: William G. Johnson date 9/25/03

Existing System Inspection by: date

HEALTH DEPT. COPY: WHITE OWNER COPY (FINAL): YELLOW OWNER COPY (INITIAL): PINK