IREDELL COUNTY HEALTH DEPARTMENT

THIS PERMIT VOIDS PREVIOUS ISSUED 8-13-01

STATESVILLE 704-878-5305 ✓ MOORESVILLE 704-664-5281

IMPROVEMENT PERMIT / AUTHORIZATION TO CONSTRUCT / OPERATION PERMIT / EXISTING SYSTEM INSPECTION

PERMIT# 101479 PIN# 4737-23-5364.10 DATE 10-9-2001

OWNER OR CONTRACTOR CRANDALL & O'BRIEN PHONE: Business (704) 871-1536 Home

ADDRESS 310 TREEBARK RD, STATESVILLE NC 28625

LOCATION NC 115 N, TR3 CHIPLEY FORD, TL RED CHIMNEY RD, 2ND LOT ON RIGHT

SUBDIVISION CHIMNEY RIDGE BLOCK / SECTION LOT 10 LOT AREA 0.567 ACRE SITE CLASS PS DESIGN FLOW 360 L.T.A.R. 0.25 GPD/FT²

Septic Tank: 1000 Gallons; STB 1012 Date 8-26-01
Pump Tank: Gallons; PT Date
Pump Make: Model Serial No
Nitrification Field: No Fields 1 Square Feet EQ. TO 1440 Linear Feet 360'
No Lines SIX Trench Width 36" Max Trench Bottom Depth 36" Gravel Depth N/A

✓ New System ☐ Repair System Type: I, II, III, IV, V, VI
System Description: GRAVITY 25% REDUCTION
Repair System Description: PUMP PANEL
Maintenance Agreement Required: ☐ Yes ✓ No
☐ Slab ✓ Crawl Space ☐ Basement w/plumbing ☐ Basement wo/plumbing


✓ House/Mod Home No. Bedrooms 3
☐ Mobile Home No. Bathrooms 2
☐ Business No. Employees
☐ Other

Water Supply: ☐ Individual ✓ Public ☐ Community


Comments/Conditions: ① INSTALL SUBSURFACE INTERCEPT DRAINAGE DITCH 48" DEEP AT LOCATION SHOWN CONTINUING DOWN BACK PROPERTY LINE LOT #9 ② INSTALL SIXTY (60) CHAMBERS OR 36' HDS SECTIONS ON CONTOUR AS SHOWN

Comments/Conditions: - 60 Infiltrator Chambers Installed - Polylok Filter Installed; Septic Tank Marker Installed - Work (FRENCH DRAIN AMENDED BY BRADY FREEMAN) 1-10-01 4/29/02

INITIAL SITE SKETCH

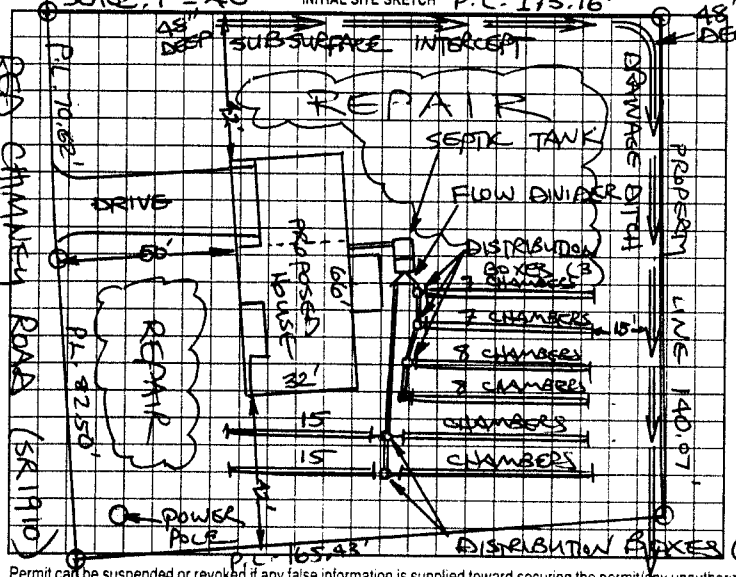

AS BUILT SKETCH

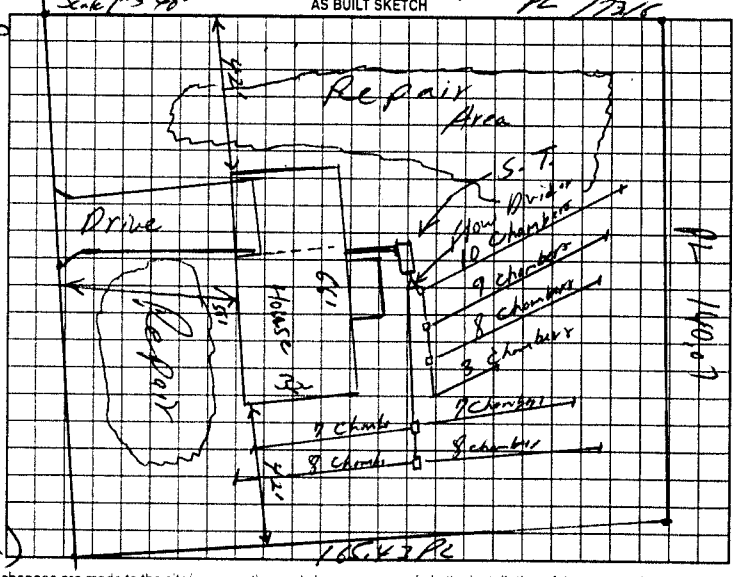

Permit can be suspended or revoked if any false information is supplied toward securing the permit, any unauthorized changes are made to the site, any unauthorized changes are made in the installation of the system. Improvement Permit with plat valid without expiration. Improvement Permit with site plan valid for sixty months. Authorization to Construct is valid for a period equal to that of Improvement Permit – not to exceed sixty months.

Signed: [signature] date 10-9-01 Installed by: A-1 Backhoe

Improvement Permit by: STEVE HEDRICK date 10-9-2001 Operation Permit by: William O. Johnson date 4/29/02

Authorization to Construct by: STEVE HEDRICK date 10-9-2001 Existing System Inspection by: date

HEALTH DEPT. COPY: WHITE OWNER COPY (FINAL): YELLOW OWNER COPY (INITIAL): PINK