This permit voids previously issued permit dated 8/13/01.

IREDELL COUNTY HEALTH DEPARTMENT

STATESVILLE 704-878-5305 MOORESVILLE 704-664-5281

IMPROVEMENT PERMIT / AUTHORIZATION TO CONSTRUCT / OPERATION PERMIT / EXISTING SYSTEM INSPECTION

PERMIT# 101475 PIN# 4737-23-5364.07 DATE 6/5/02

OWNER OR CONTRACTOR Clandle & O'Brien Construction PHONE: Business 871-1536 Home

ADDRESS 310 Treckerk Road Statesville N.C. 28625

LOCATION Chifley Ford (N) - TL Chimney Ridge - ON Lt.

SUBDIVISION Chimney Ridge BLOCK / SECTION LOT 7 LOT AREA .552 SITE CLASS PS DESIGN FLOW 360 L.T.A.R. .25 app.

Septic Tank: 1,000 Gallons: STB 1007 Date 09/09/02
Pump Tank: Gallons: PT Date
Pump Make: Model Serial No
Nitrification Field: No Fields 1 Square Feet 7440 Linear Feet 360
No Lines 6 Trench Width 36" Max Trench Bottom Depth 36" Gravel Depth —

X New System ☐ Repair System Type: I. II (III) IV. V. VI
System Description: Gravity, 25% Redu
Repair System Description: Pump, Panel
Maintenance Agreement Required: ☐ Yes X No

X House/Mod. Home No. Bedrooms 3
☐ Mobile Home No. Bathrooms 3
☐ Business No. Employees
☐ Other


☐ Slab X Crawl Space ☐ Basement w/plumbing ☐ Basement wo/plumbing

Water Supply: ☐ Individual X Public ☐ Community

Comments/Conditions: Obtain top Proper Setbacks ② Install liner on contour ③ do not install when wet ④ Install 25% Reduction System

Comments/Conditions. SEPTIC TANK INSTALLED USING POLY-LOK FILTER & SEPTIC MARKER

INITIAL SITE SKETCH Scale 1"=50'

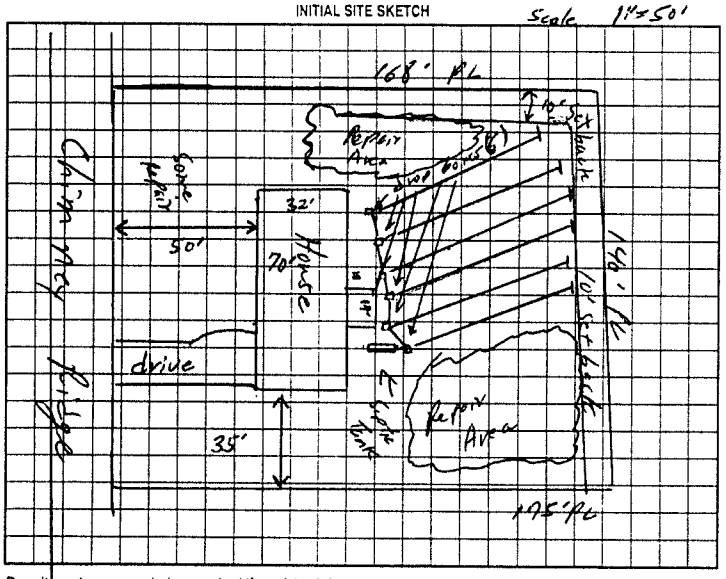

AS BUILT SKETCH

*SYSTEM INSTALLED AS SHOWN IN INITIAL SITE SKETCH.

Permit can be suspended or revoked if any false information is supplied toward securing the permit/any unauthorized changes are made to the site any unauthorized changes are made in the installation of the system. Improvement Permit with plat valid without expiration. Improvement Permit with site plan valid for sixty months. Authorization to Construct is valid for a period equal to that of Improvement Permit – not to exceed sixty months

Signed: date 6-5-02 Installed by SCOTT GREENE GRADING

Improvement Permit by: date 6/5/02 Operation Permit by: date 11/08/02

Authorization to Construct by: date 6/5/02 Existing System Inspection by: date

HEALTH DEPT COPY. WHITE OWNER COPY (FINAL) YELLOW OWNER COPY (INITIAL) PINK