IREDELL COUNTY HEALTH DEPARTMENT

STATESVILLE 704-878-5305 MOORESVILLE 704-664-5281

IMPROVEMENT PERMIT / AUTHORIZATION TO CONSTRUCT / OPERATION PERMIT / EXISTING SYSTEM INSPECTION

PERMIT# NONE PIN#

OWNER OR CONTRACTOR LG. WHITE PHONE: Business DATE 9-10-98

ADDRESS 2931 S. CHIPLEY FORD, STATESVILLE, NC 28625 Home 876-4485

LOCATION NC 115 N, TR S. CHIPLEY FORD, ON LEFT AT BOX # 2931

SUBDIVISION BLOCK / SECTION LOT LOT AREA AMPLE SOIL CLASS PS DESIGN FLOW 240 L.T.A.R. 0.30 GPD/FT²

Septic Tank EXISTING Gallons; STB Date

Pump Tank: Gallons; PT Date

Pump Make: Model Serial No.

Nitrification Field: No Fields 1 Square Feet 810 Linear Feet 270

No Lines TWO Trench Width 36" Max Trench Bottom Depth 36" Gravel Depth 12"

☑ New System ☐ Repair System Type: I, II, III, IV, V, VI

System Description: CONVENTIONAL GRAVITY

Repair System Description: CONV. GRAVITY

Maintenance Agreement Required: ☐ Yes ☑ No

☑ House/Mod. Home No. Bedrooms 2

☐ Mobile Home No. Bathrooms 2

☐ Business No. Employees

☐ Other

☐ Slab ☐ Crawl Space ☑ Basement w/plumbing ☐ Basement wo/plumbing


Water Supply: ☑ Individual ☐ Public ☐ Community

WELL


Comments:/Conditions: ① PUMP-OUT EXISTING SEPTIC TANK & REPLACE SANITARY TEE IF NECESSARY ② SMOOTH DRAINFIELD TO PROVIDE UNIFORM SLOPE ③ ABANDON EXISTING DRAINFIELD

Comments:/Conditions: Note 2 clean-outs added to line line from Tank to drainfield very deep.

INITIAL SITE SKETCH SCALE: 1" = 60'

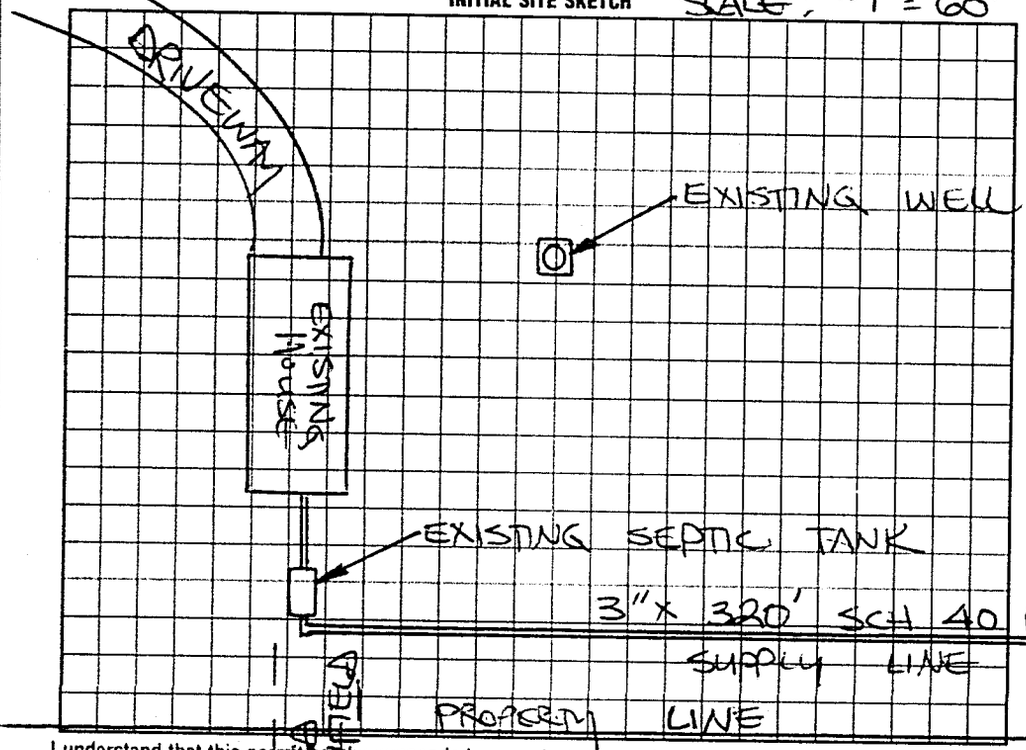

AS BUILT SKETCH

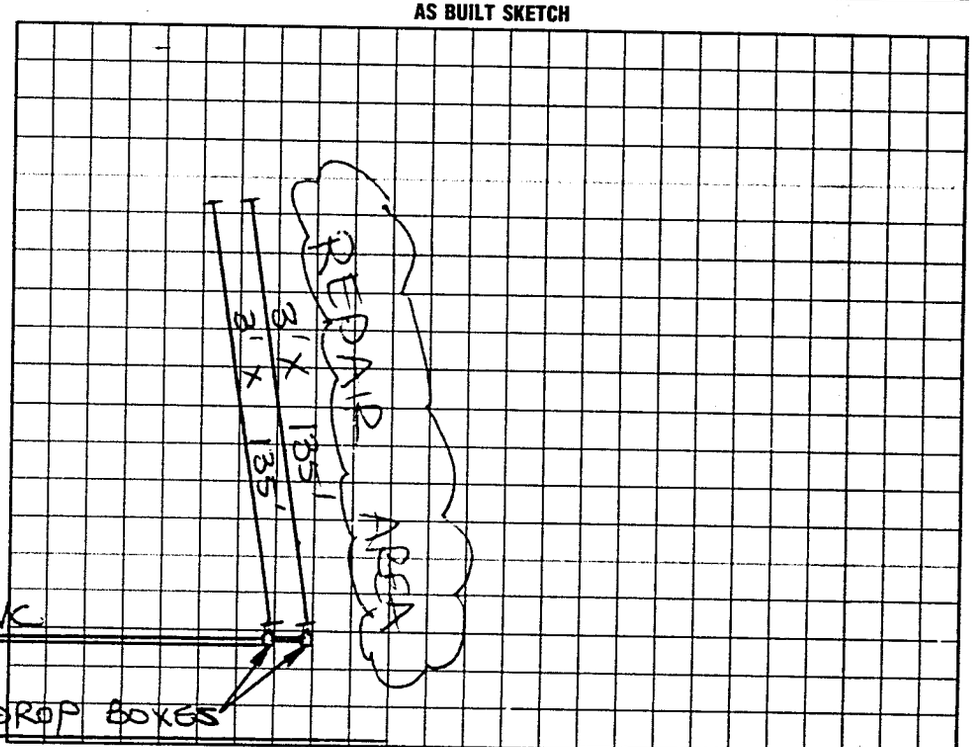

I understand that this permit can be suspended or revoked if any false information is supplied toward securing the permit/any unauthorized changes are made to the site/any unauthorized changes are made in the installation of the system. Improvement Permit with plat valid without expiration. Improvement Permit with site plan valid for sixty months. Authorization to Construct is valid for a period equal to that of Improvement Permit – not to exceed sixty months.

Signed: Thomas Burke date 9-10-98 Installed by: James Hudler

Improvement Permit by: STEVE FEDRICK date 9-10-98 Operation Permit by: Mat C Dtf Ps date 9-29-98

Authorization to Construct by: STEVE FEDRICK date 9-10-98 Existing System Inspection by date

HEALTH DEPT COPY WHITE INSPECTION COPY (FINAL) GREEN OWNER COPY (FINAL) YELLOW INSPECTION COPY (INITIAL) PINK OWNER COPY (INITIAL) GOLD

9 6 7 0 0 0