IREDELL COUNTY HEALTH DEPARTMENT

Statesville Office (704) 878-5305 | Mooresville Office (704) 660-3625 | PERMIT # 302918

SEPTIC IMPROVEMENT PERMIT / AUTHORIZATION TO CONSTRUCT / OPERATION PERMIT / EXISTING SYSTEM

PIN # 4737261372

APPLICANT/OWNER: Walter Holland | APPLICANT ADDRESS: 3001 S Chipley Ford Rd

SITE ADDRESS: 3001 S. Chipley Ford Rd, Statesville 28625 | PHONE: 704-840-9590 | ALT. PHONE —

SITE DIRECTIONS: N on 15 → R on S Chipley Ford → on left ~ 4 miles | SAP CONTROLLED: ☐ YES ext ☐ NO

SUBDIVISION: — | SECTION: — | LOT # — | LOT AREA: 145.1 ac | DESIGN FLOW: ext | L.T.A.R.: ext

Septic Tank 1000 (gal) STB — Date —
Pump Tank — (gal) PT — Date —
Pump Make — Model — Serial # —
Nitrification Fields existing # Lines — Linear Ft —
Trench Width — Trench Bottom Depth(Low side) — Gravel Depth —


☐ New System ☑ Repair ☐ Expansion System Type: I II III IV V VI
System Description: —
Repair System Description: tank replacement
Maintenance Agreement Required: ☐ YES ☑ NO
☑ GRAVITY ☐ PRESSURE

☑ Residence No. Bedrooms ext
☐ Business No. Persons ext
☐ Other No. Employees —
☐ Slab ☐ Crawl Space
☑ Basement w/plumbing ☐ Basement w/o plumbing

Water Supply
☑ Private
☐ Public
☐ Community


Comments / Conditions: Pump, crush + fill existing cracked tank. inspect + replace d-box if needed.

INITIAL SITE SKETCH

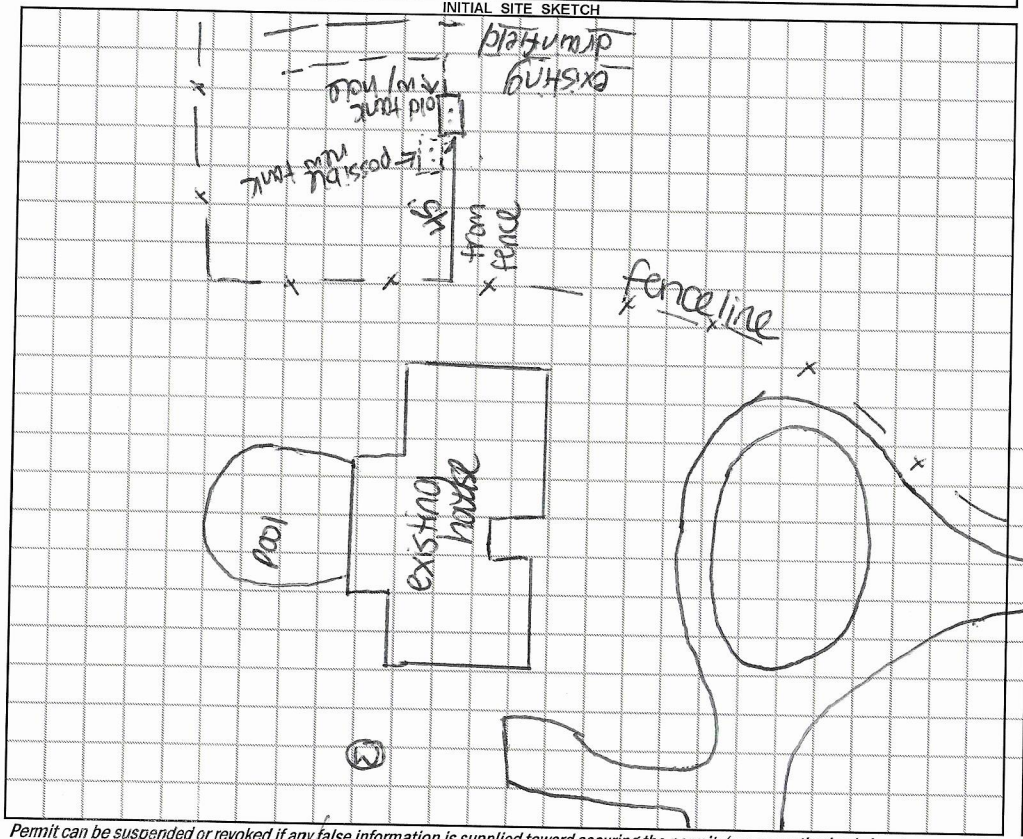

AS BUILT SKETCH

* Tank installed as shown on permit
Risers installed on Tank
D-Box appeared to be in good working order.

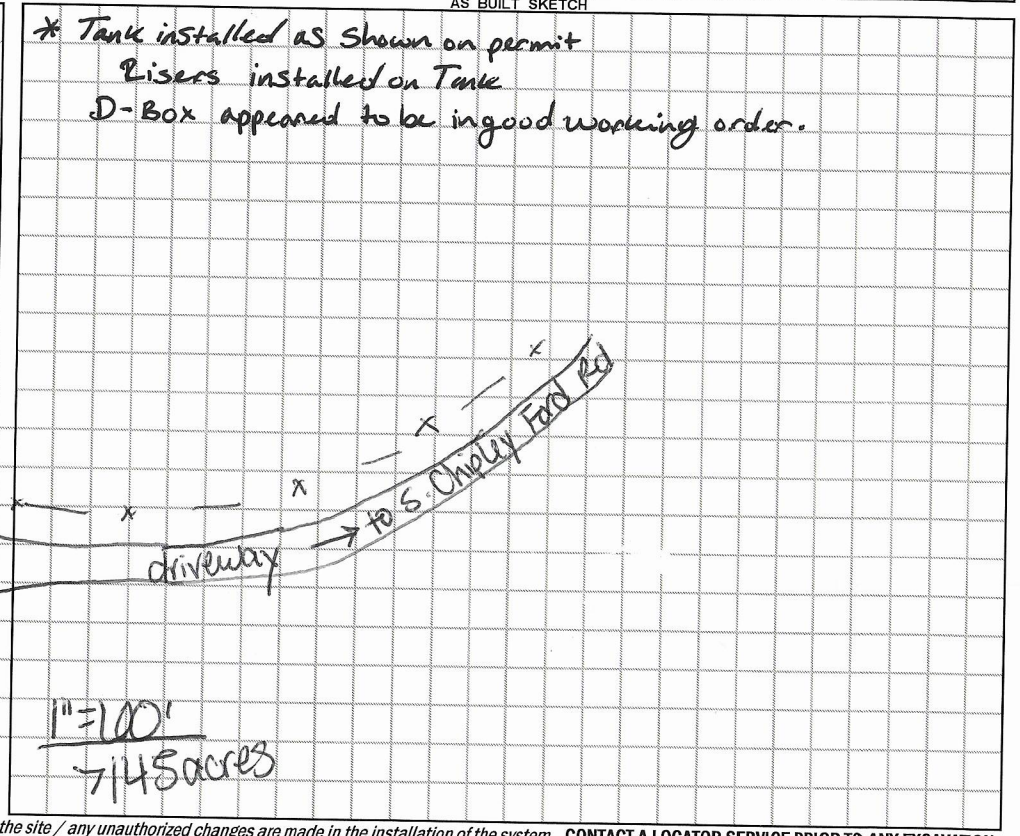

Permit can be suspended or revoked if any false information is supplied toward securing the permit / any unauthorized changes are made to the site / any unauthorized changes are made in the installation of the system. **CONTACT A LOCATOR SERVICE PRIOR TO ANY EXCAVATION**

☐ **IMPROVEMENT PERMIT** *with plat valid without expiration* ☑ **IMPROVEMENT PERMIT** *with site plan valid for 60 mos.* ☑ **AUTHORIZATION TO CONSTRUCT** *valid for period equal to IMPROVEMENT PERMIT--not to exceed 60 mo.*

Owner / Applicant Signature: Walter Holland Date: 11-26-19 Installed by: Lentz Wastewater

IMPROVEMENT PERMIT by: Carla C. Nicks Date: 11-25-19 OPERATION PERMIT by: Benjamin A. Bolton Date: 12-2-2019

AUTHORIZATION TO CONSTRUCT by: Carla C. Nicks Date: 11-25-19 Existing System Inspected by: — Date: —

FOR SEPTIC FINAL INSPECTION: CALL 704-664-3703 between 8am-9am the day the inspection is needed. Be sure to speak with an inpsector to confirm your inspection time.

APPLICATION MUST BE FILLED OUT COMPLETELY & BE LEGIBLE
OR IT WILL NOT BE PROCESSED

11-22-19

Iredell County Health Department – Environmental Health Division

PAGE 1: *APPLICATION FORM*

AP-352918 Rep. Eval. $0

Application For:
( ) New Well Permit ( ) Well Repair Permit ( ) Well Abandonment
( ) Septic Improvement Permit ( ) Authorization to Construct ( ) Existing System Inspection (X) Septic System Repair

THE ABOVE PERMIT DOCUMENTS WILL BECOME INVALID IF INFORMATION PROVIDED ON THIS APPLICATION IS FALSIFIED OR CHANGED, OR IF THE SITE IS ALTERED. THE IMPROVEMENT PERMIT IS VALID FOR EITHER 60 MONTHS OR WITHOUT EXPIRATION DEPENDING UPON DOCUMENTATION SUBMITTED. APPLICATION WITH SITE PLAN 60 MONTHS, APPLICATION WITH COMPLETE, SCALED PLAT WITHOUT EXPIRATION. SEE 15A NCAC 18A .1937(f) FOR DETAILS.

Page 2: *Site Plan Worksheet* form MUST accompany this application

The following optional attachments may also be submitted: ( ) Survey Plat, scaled no more than 1 inch = 60 feet
Place an (X) beside whichever is submitted if applicable ( ) Custom Site Plan, scaled no more than 1 inch = 60 feet

Applicant Information: (PRINT CLEARLY)

Applicant Name: Walter Holland Address: 3001 S. Chipley Ford Rd Zip: 28625
Applicant Email: hollandwalterandedie@gmail.com Phone: 7048760572 Alt. Phone: 7048409590
Owner Name: Walter Holland Address: _____ Zip: _____
Owner Email: Same Phone: _____ Alt. Phone: _____

Property Information:

Street Address: 3001 S. Chipley Ford Rd, Statesville, NC 28625
Subdivision Name: _____ Section/Phase: _____ Lot Number: _____
Driving Directions: North on Chipley Ford Rd, 0.9 mile north of intersection of S. Chipley Ford Rd & Red Chimney R

Site Development Information: *(check or complete ALL that apply*

( ) New Single Family Residence
( ) New Multi-Family Residence
( ) Accessory Building
( ) Bedroom(s) Addition
(X) Repair to failing septic system ✓ Tank ___ Drain lines Describe Problem: Top of tank is broken
Maximum Number of Bedrooms: 4
Maximum Number of Occupants: 2
(✓) Swimming Pool
( ) Other Addition/Structure: _____

CHECK FOUNDATION TYPE
(✓) Crawl Space Foundation
( ) Concrete Slab Foundation
(✓) Basement with Plumbing
( ) Basement without Plumbing

Non-Residential Site Development: Type of Business: _____
Square Footage of Building: 3000 Max. Number of Employees: _____ Max. Number of Seats/Beds/Other: _____

Water Supply: ( ) Replacement Well – Reason: _____
( ) Multi-connection Well Number of Houses: _____ Number of Persons: _____

( ) New Well (✓) Existing Well ( ) Community Well ( ) City Water ( ) Other Public Water

Desired Septic System Type: *(you may rank in order of preference)* Year existing system installed: 1965
( ) No Preference ( ) Alternative (✓) Conventional ( ) Innovative ( ) Modified Conventional ( ) Other: _____

Please answer the following to the best of your ability:
( ) Yes (✓) No Does the site contain any jurisdictional wetlands?
( ) Yes (✓) No Is any non-domestic sewage (i.e. industrial) to be generated?
( ) Yes (✓) No Is the site subject to approval by any other public agency?

I have read this application and certify that the information provided herein is true, complete, and correct. Authorized county and state officials are granted right of entry to conduct necessary inspections to determine compliance with applicable laws and rules. I understand that I am solely responsible for the proper identification and labeling of all property lines and corners and making the site accessible so that a complete site evaluation can be performed.


Signature: Walter B Holland 11-22-19
Property owner or owner's legal representative signature (SIGNATURE REQUIRED) DATE

ask well location?!!

IREDELL COUNTY DEPARTMENT of ENVIRONMENTAL HEALTH

SITE PLAN WORKSHEET

SEE THE "SAMPLE SITE PLAN" BELOW. INCOMPLETE SITE PLANS WILL BE RETURNED TO YOU FOR COMPLETION AND MAY RESULT IN A DELAY IN THE ISSUANCE OF YOUR SEPTIC SYSTEM OR WELL PERMIT!!!

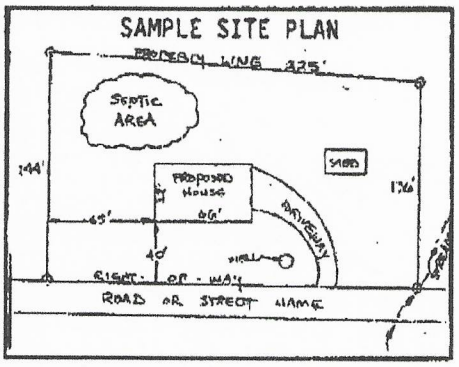

Place an (X) beside each item as you complete the site plan:

( ) **Property Line measurements are clearly identified**
( ) **All proposed structures are indicated**
( ) **Front and side setbacks from property line**
( ) **Preferred driveway location**
( ) **Preferred well location**
( ) **Preferred septic system location**
( ) **North arrow, or other sufficient indicator of direction**


Circle N/A on the following if appropriate:

Location of septic systems and wells within 100' of your property	**N/A**
Location of easements and rights of ways on your property	**N/A**
Location of any designated wetlands on the property	**N/A**

USE THIS SPACE TO DRAW YOUR SITE PLAN

Show: proposed house or business footprint, wells, water lines, patios, pools and decks, and any other item that will occupy space on the site

See Google satellite map

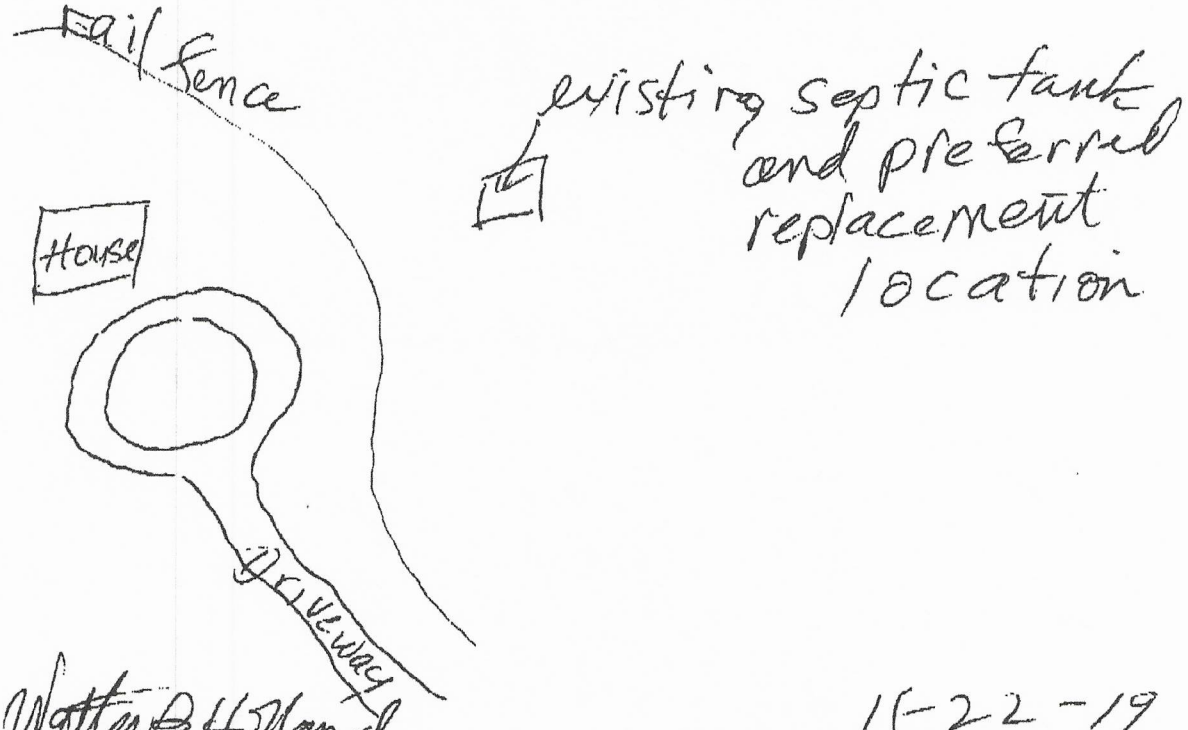

Signature: Walter B Holland

Property owner or owner's legal representative signature (SIGNATURE REQUIRED)

11-22-19

DATE

IREDELL COUNTY HEALTH DEPARTMENT

(SEPTIC TANK) IMPROVEMENTS PERMIT AND CERTIFICATE OF COMPLETION
(Ground Absorption Sewage Disposal System -- G. S. Chapter 130-Article 13C)

OWNER OR CONTRACTOR Bill Mills DATE 9/20/79 PERMIT NO. _____

PHONE: Business _____ Home _____

LOCATION Shipley Ford Rd N., in front of Brooklyn Acres

SUBDIVISION NAME _____ LOT NO. _____ SECTION OR BLOCK NO. _____ S. R. No. _____


House (✓) Mobile Home ( ) Business ( ) Other Repair

No. Bedrooms _____ No. Bathrooms _____

Garbage Disposal Unit	Yes ( )	No ( )
Auto. Dishwasher	Yes ( )	No ( )
Auto. Wash. Machine	Yes ( )	No ( )
Site Suitable	Yes ( )	No ( )

Lot Area Average

Character & Porosity of Soil Cecil Clay loam
Percolation Rate 60 min/inch
Topography 2-6%
Depth to Water Table 164
Rock or other impervious formations none

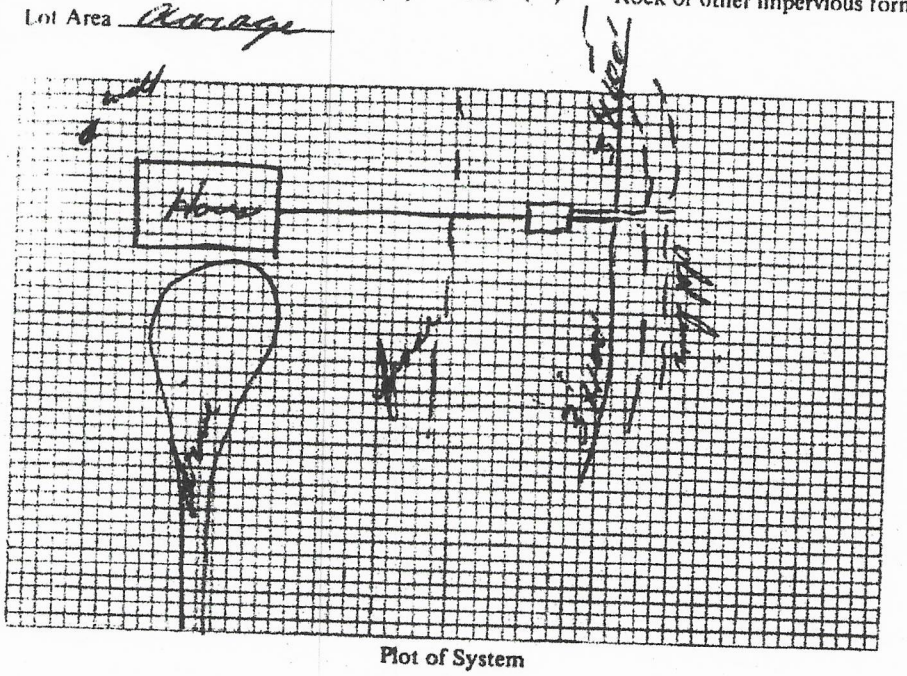

Plot of System

Size of Tank existing Gals.
Nitrification Field:
No. of Lines 2
Sq. Ft. 600 Linear Ft. 200
Depth of Stone in Lines 10"
Water Supply: Individual (✓)
Public ( )

Installed by Sam Estwatt

IMPROVEMENTS PERMIT BY J. C. Moore

COMMENTS: _____

CERTIFICATE OF COMPLETION BY Andrew C. Carey DATE 9/20/79

CONSTRUCTION MUST COMPLY WITH ALL OTHER APPLICABLE STATE AND LOCAL REGULATIONS.

Health Dept. Copy: White Inspection Dept. Copy: Yellow Sanitarian's Copy: Pink Owner's Copy: Gold

IREDELL COUNTY DEPARTMENT OF ENVIRONMENTAL HEALTH

DOCUMENTATION TO AUTHORIZE AN OWNER'S LEGAL REPRESENTATIVE

(Check and sign only ONE of the options below)

1. *** APPLICANT AND OWNER ARE THE SAME. *** *(Sign here)* Walter B Holland

Applications for permits require the "signature of the owner or owner's legal representative" (15A NCAC 18A .1937). If the owner does not sign the application himself or herself, they can submit any one of the following documents to designate their legal representative: *Power of Attorney; Real Estate Contract; Estate executor; Bankruptcy trustee; Court ordered guardianship*
In the absence of the above documentation, the property owner may provide the local health department with documentation that designates a legal representative. A property owner may:
Complete this form to document his or her legal representative, or provide his or her own form that contains the information in this form. If there are multiple property owners, then all property owners must sign the form that designates a legal representative.
By signing a form that designates a legal representative for purposes of 15A NCAC 18A .1937, the property owner authorizes that representative to act on their behalf in matters pertaining to the application and permitting process, including signing or receiving any application, document or permit. The owner retains full responsibility to meet all permit conditions specified by the local health department.

2. I, _____, am the legal owner(s) of the property located at _____, identified as

PIN (Parcel Identification Number)_____, located in Iredell County, North Carolina.

I do hereby authorize **(print legal representative/company name)** _____, _____, to act as an agent on my behalf in applying for/signing/obtaining any of the documents described below.

- Application for Improvement Permit (IP) / Authorization to Construct (AC)
- Improvement Permit (IP) / Authorization to Construct (AC)
- Application for soil-site evaluation (new/repair)
- Application/permit for private drinking water well/well abandonment
- Application for Compliance Inspection

I agree to abide by all decisions and/or conditions between the legal representative acting on my behalf and the Iredell County Department of Public Health, Environmental Health Division.

Walter B Holland — Signature of Owner(s)

11-22-19 — Date

Mooresville - Environmental Health
ronda.hart@co.iredell.nc.us
Fax: 704-662-3239
610 E. Center Avenue, Mooresville, NC 28115

Statesville - Environmental Health
adrienne.shea@co.iredell.nc.us
Fax: 704-871-3483
349 N. Center Street, Statesville, NC 28677