IREDELL COUNTY HEALTH DEPARTMENT

STATESVILLE 704-878-5305 MOORESVILLE 704-664-5281

IMPROVEMENT PERMIT / CERTIFICATE OF COMPLETION / OPERATION PERMIT / EXISTING SYSTEM INSPECTION

PROPERTY DESCRIPTION NO. _____ DATE 7-22-93 TAX MAP NO. _____

OWNER OR CONTRACTOR James K. Wilson PHONE: Business _____ Home 876-1867

ADDRESS RT 11 BOX 108 Statesville

LOCATION Chipley Fork Rd North Past Ingram Rd 1/2 mi TR Private Rd At old white store Yadkinville Rd

SUBDIVISION _____ BLOCK / SECTION _____ LOT _____ LOT AREA _____ SITE CLASS. _____ L.T.A.R. _____

Water Supply: ☑ Individual ☐ Community ☐ Public

Septic Tank: EX Gallons; STB _____ Date _____

Pump Tank: _____ Gallons; PT _____ Date _____

Nitrification Field: No Fields 1 Square Feet 450 Linear Feet 150

No Lines 2 Trench Width 60 Trench Depth 18"+36 Gravel Depth 18"

☐ New System ☑ Repair System Type: I, II, III, IV, V, VI

System Description: _____

Repair System Description: Conv. Gravity

Maintenance Agreement Required: ☐ Yes ☑ No

☑ House/Mod. Home No. Bedrooms _____ Garbage Disposal: ☐ Yes ☐ No

☐ Mobile Home No. Bathrooms _____ Auto. Dishwasher: ☐ Yes ☐ No


☐ Business No. Employees _____ Auto. Washing Machine: ☐ Yes ☐ No

☐ Other Repair Other _____

☐ Slab ☐ Crawl Space ☐ Basement w/plumbing ☐ Basement wo/plumbing

Comments (1) SANITARY TEE REPLACED IN SEPTIC TANK.
(2) LINE END INSTALLED > 5' DEEP

INITIAL SITE SKETCH

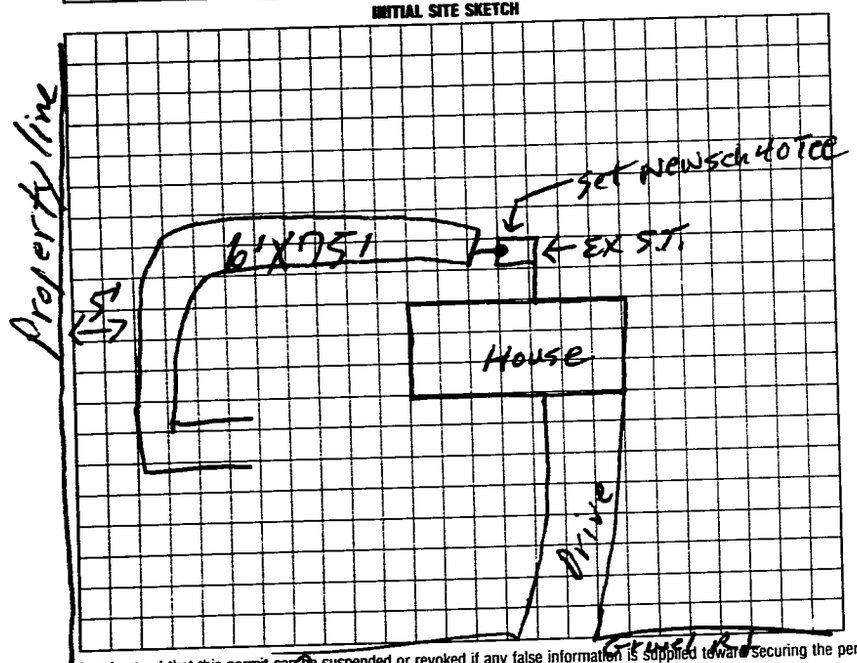

AS BUILT SKETCH

SYSTEM REPAIRED ACCORDING TO INITIAL SITE SKETCH

I understand that this permit can be suspended or revoked if any false information is supplied toward securing the permit/any unauthorized changes are made to the site/any unauthorized changes are made in the installation of the system. Improvement Permit is valid for 60 months from date of issuance.

Signed: x Mrs. James K. Wilson Installed by: JAMES HUDLER

Improvement Permit by: R. C. Moore date 7-22-93 Certificate of Completion by: STEVE HENDRICK date 7/28/93

Existing System Inspection by: _____ date _____ Operation Permit by: _____ date _____

HEALTH DEPT. COPY: WHITE INSPECTION COPY (FINAL): GREEN OWNER COPY (FINAL): YELLOW INSPECTION COPY (INITIAL): PINK OWNER COPY (INITIAL): GOLD