IREDELL COUNTY HEALTH DEPARTMENT

STATESVILLE 704-878-5305 MOORESVILLE 704-664-5281

IMPROVEMENT PERMIT / AUTHORIZATION TO CONSTRUCT / OPERATION PERMIT / EXISTING SYSTEM INSPECTION

PERMIT# 074748 PIN# 4737 24 9932 (PT) DATE 8-7-98

OWNER OR CONTRACTOR THOMAS BEATY PHONE: Business Home 878-2244

ADDRESS 1163 OLD MOUNTAIN ROAD, STATESVILLE, NC 28677

LOCATION NC 115 N, TR S, CHIPLEY FORD, ON LEFT PAST RED CHIMNEY ROAD AT BOX # 2945

SUBDIVISION BLOCK / SECTION LOT LOT AREA 2.4 ACRES SITE CLASS PS DESIGN FLOW 480 L.T.A.R. 0.33 GPD/FT²

Septic Tank: 1000 Gallons; STB 1000 Date 6-9-00
Pump Tank: Gallons; PT Date
Pump Make: Model Serial No.
Nitrification Field: No. Fields 1 Square Feet 1440 Linear Feet 480
No. Lines FOUR Trench Width 36" Max Trench Bottom Depth 36" Gravel Depth 12"

☑ New System ☐ Repair System Type: I (II) III, IV, V, VI
System Description: CONVENTIONAL GRAVITY
Repair System Description: CONV. GRAVITY
Maintenance Agreement Required: ☐ Yes ☑ No

☑ House/Mod. Home No. Bedrooms 4
☐ Mobile Home No. Bathrooms 2½
☐ Business No. Employees
☐ Other


☐ Slab ☑ Crawl Space ☐ Basement w/plumbing ☐ Basement wo/plumbing

Water Supply: ☐ Individual ☑ Public ☐ Community

Comments:/Conditions: SCOUR TRENCH SIDEWALLS WHERE SMEARING OCCURS

Comments:/Conditions:

INITIAL SITE SKETCH ~ SCALE: 1"=50'

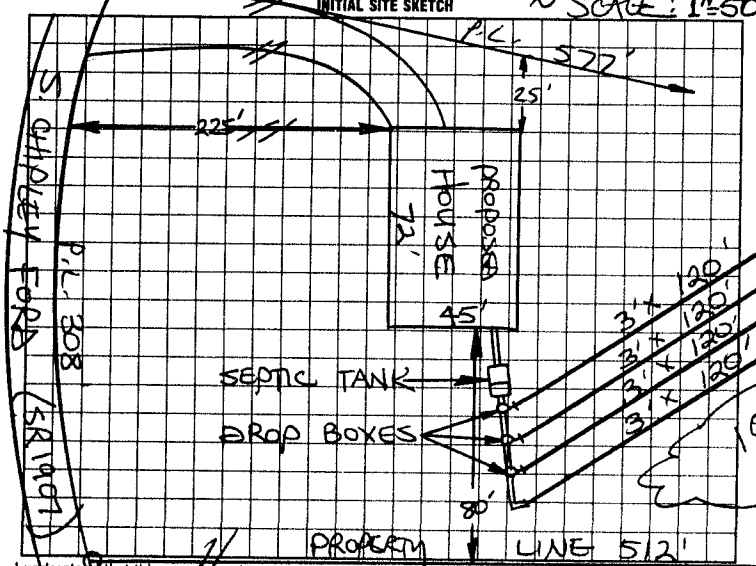

AS BUILT SKETCH

SYSTEM INSTALLED ACCORDING TO INITAL SITE SKETCH

I understand that this permit can be suspended or revoked if any false information is supplied toward securing the permit/any unauthorized changes are made to the site/any unauthorized changes are made in the installation of the system. Improvement Permit with plat valid without expiration. Improvement Permit with site plan valid for sixty months. Authorization to Construct is valid for a period equal to that of Improvement Permit – not to exceed sixty months.

Signed: + Thelody M. Beaty date 8-7-98

Improvement Permit by: STEVE HEDRICK date 8-7-98

Authorization to Construct by: STEVE HEDRICK date 8-7-98

Installed by: JAMES HUGER

Operation Permit by: STEVE HEDRICK date 8-7-2000

Existing System Inspection by: date

HEALTH DEPT. COPY: WHITE INSPECTION COPY (FINAL) GREEN OWNER COPY (FINAL) YELLOW INSPECTION COPY (INITIAL) PINK OWNER COPY (INITIAL) GOLD