IREDELL COUNTY HEALTH DEPARTMENT - *ENVIRONMENTAL HEALTH* ☐ STATESVILLE OFFICE 704-878-5305 ☐ MOORESVILLE OFFICE 704-664-5281

IMPROVEMENT PERMIT / AUTHORIZATION TO CONSTRUCT / OPERATION PERMIT / EXISTING SYSTEM INSPECTION

PERMIT # REPAIR PIN # 4737-35-6902 DATE MAY 15, 2012

OWNER ERIC M. DAVIDSON APPLICANT: SAME PHONE: Home/Cell # 704-876-3473 Business # 704-775-0499

SITE ADDRESS 2992 SOUTH CHIPLEY FORD RD. OWNER / APPLICANT ADDRESS SAME STATESVILLE NC 2

SITE DIRECTIONS NC 115 NORTH TR S. CHIPLEY FORD ROAD ON RIGHT AT BOX # 2992

SUBDIVISION PRESSLEY ACRES BLOCK / SECTION A LOT # LOT AREA 0.427 AC DESIGN FLOW 360 L.T.A.R.

Septic Tank 1000 Gallons: STB 1012 Date 11-22-

Pump Tank Gallons: P T Date

Pump Make Model Serial #

No. Nitrification Fields: 1 No. Lines EX Linear Feet EX

Trench Width EX Max. Trench Bottom Depth EX Gravel Depth EX

☐ New System ☑ Repair ☐ Expansion System Type I (II) III IV V VI

System Description:

Repair System Description: CONVENTIONAL SEPTIC TANK

Maintenance Agreement Required ☐ YES ☑ NO

☑ GRAVITY ☐ PRESSURE


☑ Residence ☐ Business ☐ Other ☐ Slab ☐ Basement w/plumbing

No. Bedrooms 3 No. Persons No. Employees ☑ Crawl Space ☐ Basement w/o plumbing


Water Supply: ☐ Private ☐ Public ☑ Community

Comments / Conditions: INSTALL NEW 1000 GALLON SEPTIC TANK AT LOCATION SHOWN USING ACCESS RISERS. KEEP MINIMUM 5' FROM DECK FOUNDATION POST

INITIAL SITE SKETCH

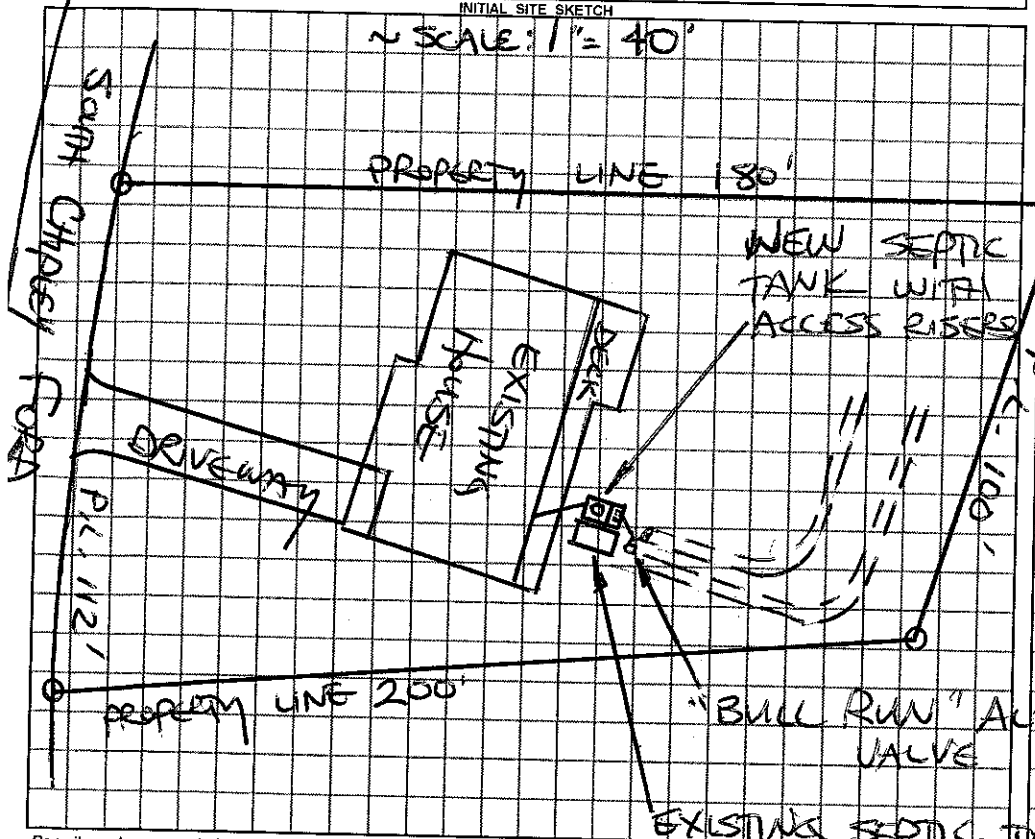

AS BUILT SKETCH

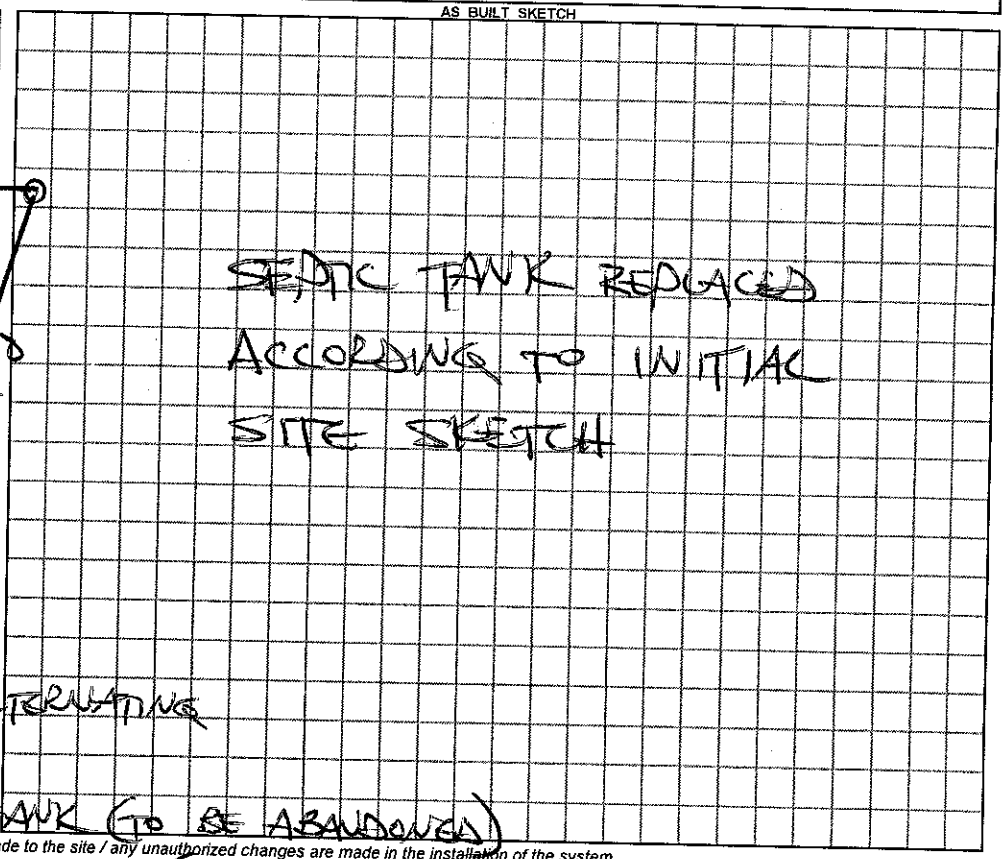

Permit can be suspended or revoked if any false information is supplied toward securing the permit / any unauthorized changes are made to the site / any unauthorized changes are made in the installation of the system.

☐ ***IMPROVEMENT PERMIT*** with plat valid without expiration. ☑ ***IMPROVEMENT PERMIT*** with plat ~~valid without expiration.~~ site plan valid 60 mo. ☑ ***AUTHORIZATION TO CONSTRUCT*** valid for period equal to IMPROVEMENT PERMIT--not to exceed 60 mo.

Owner / Applicant Signature: [signature] Date 5-16-12 Installed by: PIEDMONT BACKHOE

IMPROVEMENT PERMIT by: STEVE HEDRICK REHS Date 5/15/12 OPERATION PERMIT by: STEVE HEDRICK REHS Date 5/17/12

AUTHORIZATION TO CONSTRUCT by: STEVE HEDRICK REHS Date 5/15/12 Existing System Inspected by: REHS Date

YOU SHOULD CONTACT A LOCATOR SERVICE PRIOR TO ANY EXCAVATION

White Copy – Environmental Health YELLOW COPY (Final) Owner / Applicant PINK COPY (Initial) Owner / Applicant