IREDELL COUNTY HEALTH DEPARTMENT

Statesville Office (704) 878-5305 Mooresville Office (704) 660-3625 PERMIT # 17666

IMPROVEMENT PERMIT / AUTHORIZATION TO CONSTRUCT / OPERATION PERMIT / EXISTING SYSTEM

PIN # 4737369352

APPLICANT: Jonathan Kuehm APPLICANT ADDRESS: 110 Pratt Ln

SITE ADDRESS: 110 Pratt Ln PHONE: 828-446-9597 ALT. PHONE: N/A

SITE DIRECTIONS: S Chipley Ford Rd to Pratt Ln Property on Right


SUBDIVISION: Pressley Acres SECTION: N/A LOT # 6 LOT AREA: 0.5 acres DESIGN FLOW: 360 gpd L.T.A.R.: Existing

Septic Tank	1000	(gal)	STB	700	Date	9-24-12	☐ New System	☑ Repair	☐ Expansion	System Type: I	II III IV V VI
Pump Tank		(gal)	PT		Date		System Description:				
Pump Make			Model		Serial #		Repair System Description:	TANK			
# Nitrification Fields	2	# Lines	Existing		Linear Ft:	Ex	Maintenance Agreement Required:	☐ YES	☑ NO		
Trench Width	Ex	Max. Trench Bottom Depth	Ex		Gravel Depth	Ex		☐ GRAVITY	☐ PRESSURE		

☑ Residence	No. Bedrooms		Water Supply
☐ Business	No. Persons		☐ Private
☐ Other	No. Employees		☐ Public
☐ Slab	☑ Crawl Space		☑ Community
☐ Basement w/plumbing	☐ Basement w/o plumbing		

Comments / Conditions: Pump & Crush existing septic tank. Connect new septic tank to existing drainfields utilizing existing Bull-run valve

INITIAL SITE SKETCH

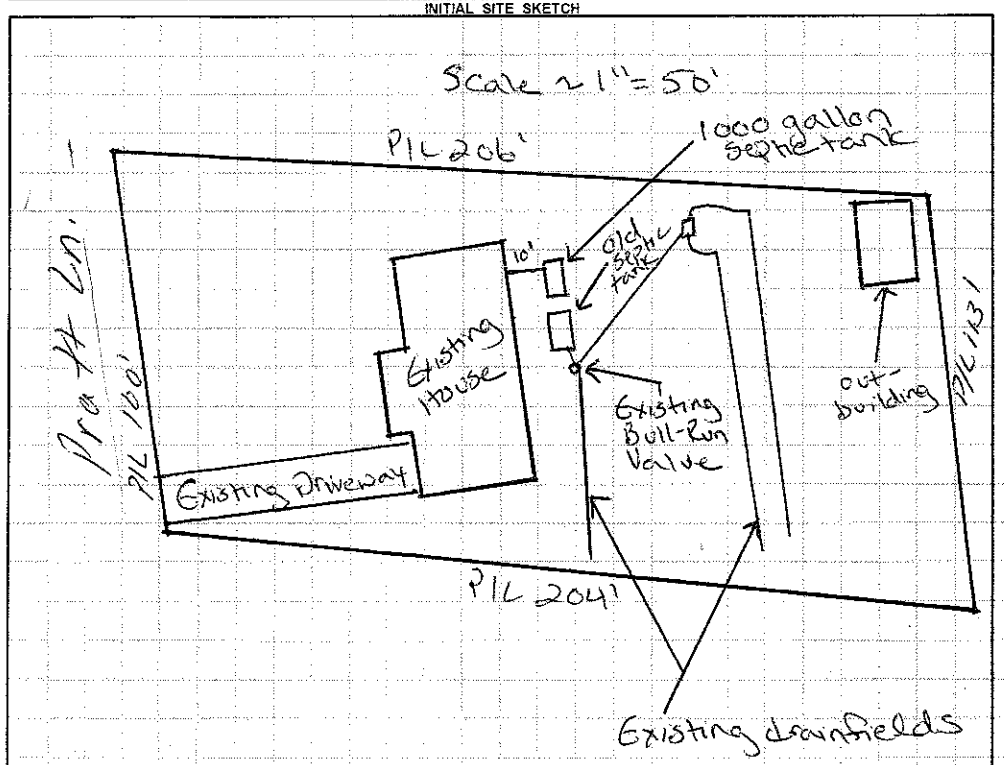

AS BUILT SKETCH

Permit can be suspended or revoked if any false information is supplied toward securing the permit / any unauthorized changes are made to the site / any unauthorized changes are made in the installation of the system. **CONTACT A LOCATOR SERVICE PRIOR TO ANY EXCAVATION**

☐ **IMPROVEMENT PERMIT** *with plat valid without expiration.* ☑ **IMPROVEMENT PERMIT** *with site plan valid for 60 mos.* ☑ **AUTHORIZATION TO CONSTRUCT** *valid for period equal to IMPROVEMENT PERMIT--not to exceed 60 mo.*

Owner / Applicant Signature: Jonathan Kuehm Date: 1/18/13 Installed by: A1 Backhoe

IMPROVEMENT PERMIT by: Justin Henderson Date: 1-16-13 OPERATION PERMIT by: Justin Henderson Date: 2-21-13

AUTHORIZATION TO CONSTRUCT by: Justin Henderson Date: 1-16-13 Existing System Inspected by: Date:

Health Dept. Copy - WHITE Applicant (Final Approval) - YELLOW Applicant (Conditional Approval) - PINK