IREDELL COUNTY HEALTH DEPARTMENT

Statesville Phone TR 3-7271 — Mooresville Phone NO 3-1271

PERMIT TO INSTALL SEPTIC TANK

Permit No. 154 — Permit Date 7-6 1972

Owner Blos. FLAKE PRATT — Address STATESVILLE, NC

Installed By Robt. Bost — Address STATESVILLE, NC


Location of Property Shipley Ford Rd. To Pressley Acres — 2nd Lot on R. Pratt St.

Tank		Capacity		Length of Lines		Fixtures	
Block	( )	1000	(✓)	225'	( )	No. of Baths	(1½)
Precast	(✓)	1250	( )	250'	( )	Dishwasher	( )
		1500	( )	Other 270 60 Left.		Garbage Grdr.	( )
		Other				Other	

NOTIFY HEALTH DEPARTMENT AT LEAST EIGHT HOURS BEFORE TANK IS TO BE INSPECTED.

Final Inspection 7-6 1972 — Approved (✓) Disapproved ( )

Remarks Community Water Supply

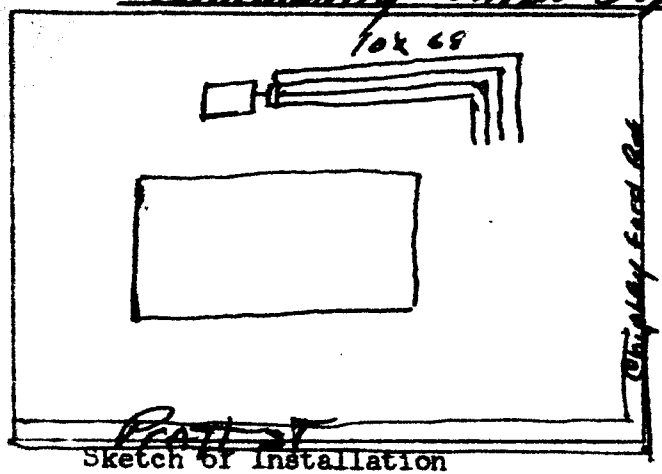

Sketch of Installation

Sanitarian