59425

IREDELL COUNTY HEALTH DEPARTMENT

STATESVILLE 704-878-5305 MOORESVILLE 704-664-5281

IMPROVEMENT PERMIT / CERTIFICATE OF COMPLETION / OPERATION PERMIT / EXISTING SYSTEM INSPECTION

PROPERTY DESCRIPTION NO 23104 DATE 2-21-96 TAX MAP NO 10E-A-47 (PART OF) Watershed: ☐ Yes ☑ No

OWNER OR CONTRACTOR BENNIE WILSON PHONE: Business _____ Home 873-3388

ADDRESS 310 CHESTNUT STREET, STATESVILLE, NC, 28677

LOCATION NC 115 N, TR 5, CHIPLEY FORD, TL BRANCHWOOD ROAD, ~0.3 MILE ON LEFT

SUBDIVISION W.A. MILLS Prop, BLOCK / SECTION _____ LOT 3B LOT AREA 15.32 ACRES SITE CLASS PS DESIGN FLOW 600 L.T.A.R. 0.30 GPD/FT²

Septic Tank: 1500 Gallons; STB 1011 Date 7-8-96
Pump Tank: _____ Gallons; PT _____ Date _____
Pump Make: _____ Model _____ Serial No _____
Nitrification Field: No Fields 1 Square Feet 1980 Linear Feet 660
No Lines 6 Trench Width 36" Max Trench Bottom Depth 20-36" Gravel Depth 12"

☑ New System ☐ Repair System Type: I (II) III IV V VI
System Description: CONVENTIONAL GRAVITY
Repair System Description: CONVENTIONAL GRAVITY
Maintenance Agreement Required Yes ☑ No


☑ House/Mod Home No Bedrooms 5
☐ Mobile Home No Bathrooms 4
☐ Business No Employees ___
☐ Other _____
☐ Slab ☐ Crawl Space ☑ Basement w/plumbing ☐ Basement wo/plumbing

Water Supply: ☐ Individual ☑ Community ☑ Public

Comments: ① USE ONE FLOW DIVIDER TEE TO EVENLY DISTRIBUTE EFFLUENT INTO TWO SERIES OF DROP BOXES FEEDING THREE 110' LINES EACH ② INSTALL LINES AS FLAGGED ON CONTOUR, NO DEEPER THAN 36", 9' MIN. APART ON CENTER

Comments:

INITIAL SITE SKETCH

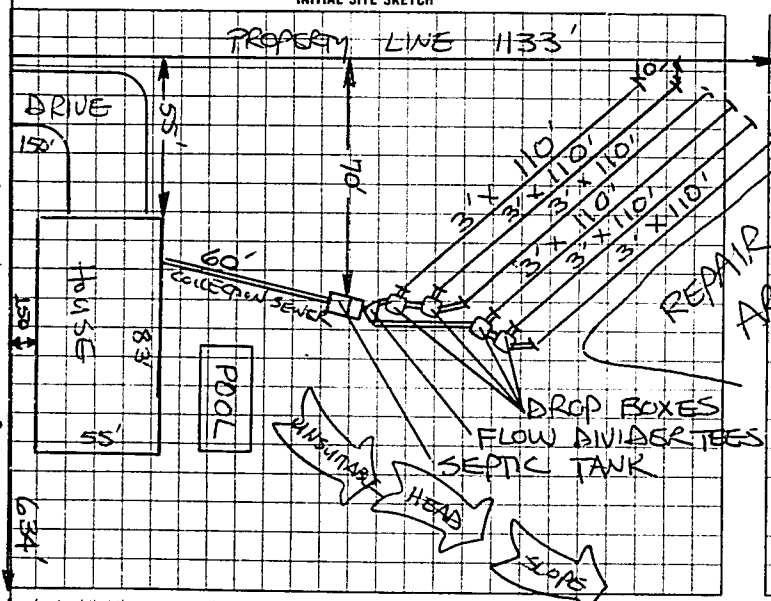

AS BUILT SKETCH

SYSTEM INSTALLED ACCORDING TO INITIAL SITE SKETCH

I understand that this permit can be suspended or revoked if any false information is supplied toward securing the permit/any unauthorized changes are made to the site/any unauthorized changes are made in the installation of the system

AUTHORIZATION TO CONSTRUCT IS VALID FIVE (5) YEARS FROM DATE OF ISSUANCE. IMPROVEMENT PERMIT HAS NO EXPIRATION DATE.

Signed Bennie Wilson

Improvement Permit by STEVE HEDRICK date 2-21-96

~~Authorization to Construct~~ Existing System Inspection by STEVE HEDRICK date 2-21-96

Installed by TOMMY FRYE

~~Certificate of Completion by~~ _____ date _____

Operation Permit by STEVE HEDRICK date 9-16-96

HEALTH DEPT COPY WHITE INSPECTION COPY (FINAL) GREEN OWNER COPY (FINAL) YELLOW INSPECTION COPY (INITIAL) PINK OWNER COPY (INITIAL) GOLD

2 8 2 0 0