IREDELL COUNTY HEALTH DEPARTMENT

STATESVILLE 704-878-5305 MOORESVILLE 704-664-5281

IMPROVEMENT PERMIT / AUTHORIZATION TO CONSTRUCT / OPERATION PERMIT / EXISTING SYSTEM INSPECTION

PERMIT# 089711 PIN# 4737 44 5410 (PART) DATE 6-10-2000

OWNER OR CONTRACTOR CYNTHIA GIBSON PHONE: Business Home 876-6351

ADDRESS 2769 S. CHIPLEY FORD ROAD, STATESVILLE, NC 28625

LOCATION S. CHIPLEY FORD ROAD, TR INGRAM ROAD, TL GIBSON FARM LANE, AT END ON RIGHT

SUBDIVISION BLOCK / SECTION LOT LOT AREA 1.00 ACRES SITE CLASS PS DESIGN FLOW 360 L.T.A.R. 0.40 GPD/FT²

Septic Tank: 1000 Gallons; STB Date

Pump Tank: Gallons; PT Date

Pump Make: Model Serial No.

Nitrification Field: No Fields 1 Square Feet 900 Linear Feet 300

No Lines FIVE Trench Width 36" Max Trench Bottom Depth 36" Gravel Depth 12"

☑ New System ☐ Repair System Type: I (II) III. IV. V. VI

System Description: CONVENTIONAL GRAVITY

Repair System Description: CONV. PUMP-PED

Maintenance Agreement Required: ☐ Yes ☑ No

☐ Slab ☐ Crawl Space ☑ Basement w/plumbing ☐ Basement wo/plumbing

☑ House/Mod. Home No. Bedrooms 3

☐ Mobile Home No. Bathrooms 2

☐ Business No. Employees

☐ Other


Water Supply: ☑ Individual ☐ Public ☐ Community WELL

Comments:/Conditions: KEEP SYSTEM MINIMUM 100 FEET FROM WELL.

Comments /Conditions — Poly Lok Filter Installed

— Septic tank Risers Installed

INITIAL SITE SKETCH SCALE: 1" = 60'

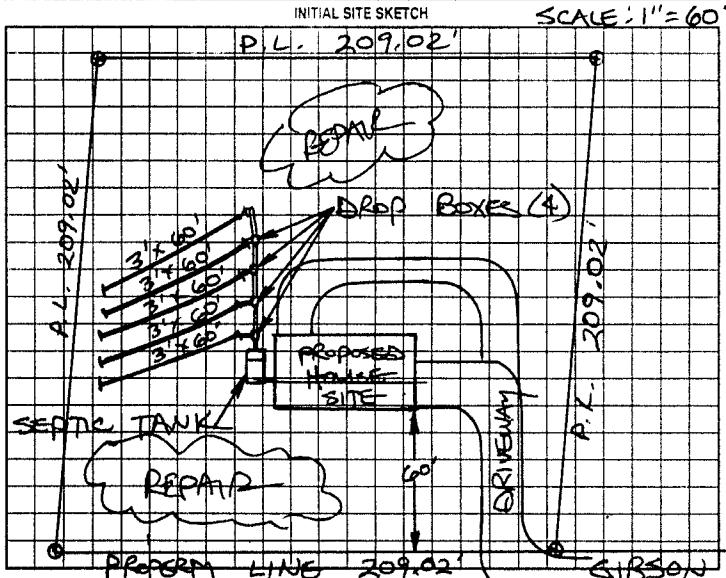

AS BUILT SKETCH

Installed as shown per Initial Site Sketch

Permit can be suspended or revoked if any false information is supplied toward securing the permit/any unauthorized changes are made to the site/any unauthorized changes are made in the installation of the system. Improvement Permit with plat valid without expiration. Improvement Permit with site plan valid for sixty months. Authorization to Construct is valid for a period equal to that of Improvement Permit – not to exceed sixty months.

Signed: Hal Gibson date 6-10-00 Installed by: David Kountz

Improvement Permit by: STEVE HEDRICK date 6-10-2000 Operation Permit by: William A. Johnson NSI date 4-23-01

Authorization to Construct by: STEVE HEDRICK date 6-10-2000 Existing System Inspection by: date

HEALTH DEPT. COPY: WHITE OWNER COPY (FINAL) YELLOW OWNER COPY (INITIAL) PINK