IREDELL COUNTY HEALTH DEPARTMENT

STATESVILLE 704-878-5305 CI MOORESVILLE 704-664-5281

IMPROVEMENT PERMIT / AUTHORIZATION TO CONSTRUCT / OPERATION PERMIT / EXISTING SYSTEM INSPECTION

PERMIT# 115027 PIN# 4737-45-4847-0115 DATE 8-22-03

OWNER OR CONTRACTOR ANDY & WENDY GIBSON PHONE: Business _____ Home 704-876-4357

ADDRESS 2980 S. CHIPLEY FORD RD. STATESVILLE NC 28625

LOCATION NC 115 N, TR S. CHIPLEY RD, ON RIGHT AT BOX # 2980

SUBDIVISION _____ BLOCK / SECTION _____ LOT _____ LOT AREA 3.560 ACRES SITE CLASS. PS DESIGN FLOW 360 L.T.A.R. 0.30 GPD/FT²

Septic Tank: 1000 Gallons; STB 1012 Date 6-22-03
Pump Tank: _____ Gallons; PT _____ Date _____
Pump Make: _____ Model _____ Serial No. _____
Nitrification Field: No Fields 1 Square Feet 1200 Linear Feet 400
No Lines FIVE Trench Width 36" Max Trench Bottom Depth 36" Gravel Depth 12"

☑ New System ☐ Repair System Type: I (II) III, IV, V, VI
System Description: CONVENTIONAL, GRAVITY
Repair System Description: CONVENTIONAL, PUMP
Maintenance Agreement Required: ☐ Yes ☑ No

☐ House/Mod. Home No. Bedrooms 3
☐ Mobile Home No. Bathrooms 2½
☐ Business No. Employees _____
☐ Other _____


☐ Slab ☑ Crawl Space ☐ Basement w/plumbing ☑ Basement wo/plumbing

Water Supply: ☑ Individual ☐ Public ☐ Community
WELL

Comments/Conditions: KEEP SYSTEM MINIMUM 10 FEET FROM PROPERTY LINE, 10 FEET FROM WATER LINE, 100' PLUS TO WELL.

Comments/Conditions: - Tuff-Tite filter + S.T. Marker Installed

INITIAL SITE SKETCH

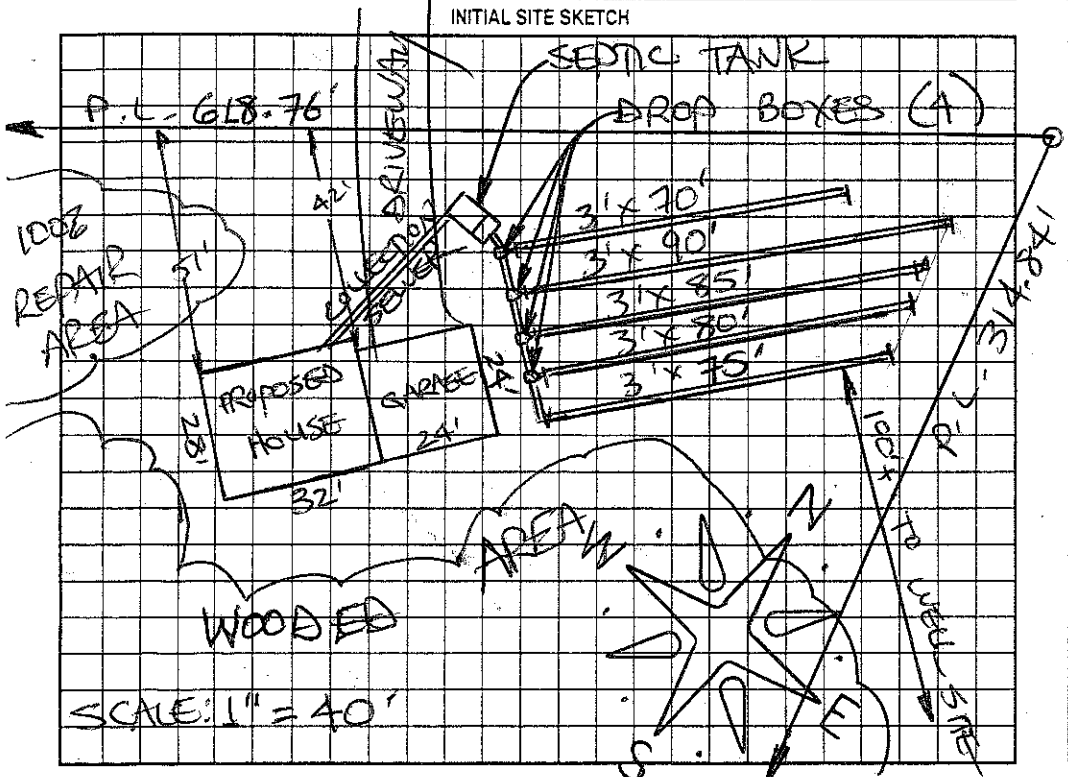

AS BUILT SKETCH

Installed As Shown per Initial Site Sketch

Permit can be suspended or revoked if any false information is supplied toward securing the permit/any unauthorized changes are made to the site/any unauthorized changes are made in the installation of the system. Improvement Permit with plat valid without expiration. Improvement Permit with site plan valid for sixty months. Authorization to Construct is valid for a period equal to that of Improvement Permit – not to exceed sixty months.

Signed: William A. Johnson date 8-22-03

Improvement Permit by: STEVE HEDRICK date 8-22-03

Authorization to Construct by: STEVE HEDRICK date 8-22-03

Installed by: Tommy Frye

Operation Permit by: William O. Johnson date 12/19/03

Existing System Inspection by: _____ date _____

HEALTH DEPT. COPY: WHITE OWNER COPY (FINAL): YELLOW OWNER COPY (INITIAL): PINK