IREDELL COUNTY HEALTH DEPARTMENT

Statesville Office (704) 878-5305 Mooresville Office (704) 660-3625 PERMIT # 178545

IMPROVEMENT PERMIT / AUTHORIZATION TO CONSTRUCT / OPERATION PERMIT / EXISTING SYSTEM

PIN # 4737461584

APPLICANT: Josh Smith APPLICANT ADDRESS: 349 Bluegill Ln.

SITE ADDRESS: 121 Pratt Ln. PHONE: 704-881-1866 ALT. PHONE: N/A

SITE DIRECTIONS: Hwy 115 N TR S. Chipley Ford Rd. TR Pratt Ln.

SUBDIVISION: Pressley Acres SECTION: N/A LOT # 29 LOT AREA: 0.48 acres DESIGN FLOW: 360 gpd L.T.A.R.: 0.3

Septic Tank Existing (gal) STB Date

Pump Tank 1000 (gal) PT 363 Date 1-10

Pump Make Goulds Model PE51M Serial # B1349160

Nitrification Fields 1 # Lines 6 Linear Ft: 288

Trench Width 36" Max. Trench Bottom Depth 36" Gravel Depth N/A

☐ New System ☑ Repair ☐ Expansion System Type: I II (III) IV V VI

System Description:

Repair System Description: 25% Reduction - Pump

Maintenance Agreement Required: ☐ YES ☑ NO

☐ GRAVITY ☑ PRESSURE

☑ Residence No. Bedrooms 3

☐ Business No. Persons

☐ Other No. Employees


☐ Slab ☑ Crawl Space

☐ Basement w/plumbing ☐ Basement w/o plumbing

Water Supply: ☐ Private ☑ Public ☐ Community

Comments / Conditions: Install a 25% Reduction system on Contour with parallel distribution.

INITIAL SITE SKETCH

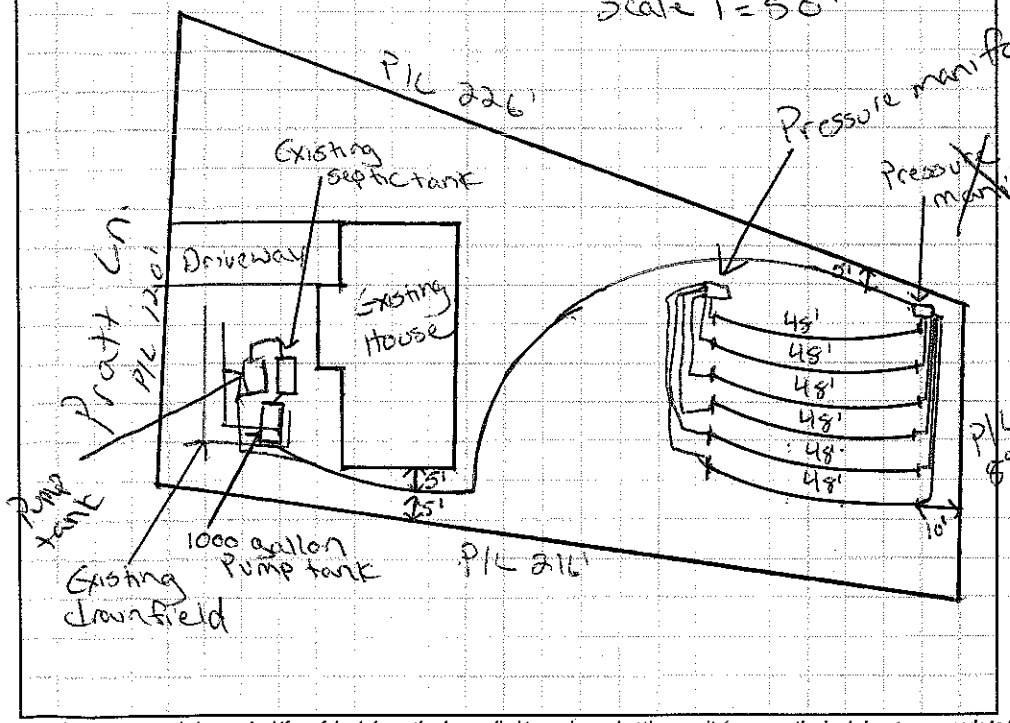

AS BUILT SKETCH

- Quick 4 Chambers installed
- Red Polylok Siter installed
- New risers on existing septic tank
- Installed as drawn

Permit can be suspended or revoked if any false information is supplied toward securing the permit / any unauthorized changes are made to the site / any unauthorized changes are made in the installation of the system. **CONTACT A LOCATOR SERVICE PRIOR TO ANY EXCAVATION**

☐ **IMPROVEMENT PERMIT** *with plat valid without expiration.* ☑ **IMPROVEMENT PERMIT** *with site plan valid for 60 mos.* ☑ **AUTHORIZATION TO CONSTRUCT** *valid for period equal to IMPROVEMENT PERMIT--not to exceed 60 mo.*

Owner / Applicant Signature: Dennard Keamon-Smith Date: 5-17-13 Installed by: Lentz Septic

IMPROVEMENT PERMIT by: Justin Henderson Date: 5-15-13 OPERATION PERMIT by: Justin Henderson Date: 5-28-13

AUTHORIZATION TO CONSTRUCT by: Justin Henderson Date: 5-15-13 Existing System Inspected by: Date:

Health Dept. Copy - WHITE Applicant (Final Approval) - YELLOW Applicant (Conditional Approval) - PINK