IREDELL COUNTY HEALTH DEPARTMENT

Statesville Phone TR 3-7271 Mooresville Phone NO 3-1271

PERMIT TO INSTALL SEPTIC TANK

Permit No. 153 Permit Date _____ 19__

Owner Ralph Porter Address _____

Installed By Dan & Jim Lackey Address _____


Location of Property Pressley Acres off Chipley Ford Rd., 2nd drive, 2nd house on right.

Tank		Capacity		Length of Lines		Fixtures	
Block	( )	1000	( )	225'	( )	No. of Baths	(1½)
Precast	(✓)	1250	( )	250'	( )	Dishwasher	( )
		1500	( )	Other _____		Garbage Grdr.	( )
		Other _____				Other _____	

NOTIFY HEALTH DEPARTMENT AT LEAST EIGHT HOURS BEFORE TANK IS TO BE INSPECTED.

Final Inspection 3-20-1972 Approved (✓) Disapproved ( )

Remarks Tank is not setting level. Community water supply.

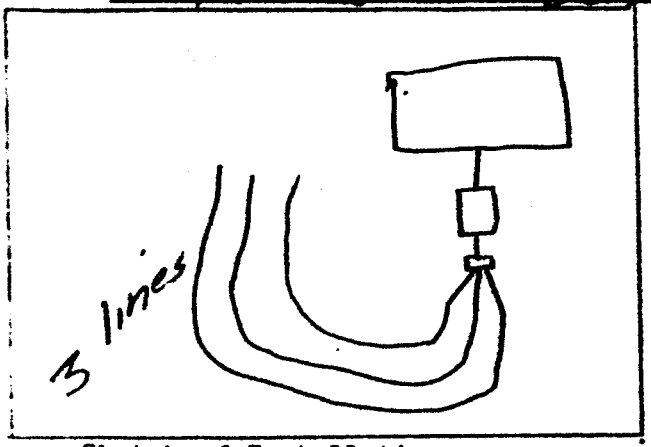

Sketch of Installation

Gene S. Hall

Sanitarian