IREDELL COUNTY HEALTH DEPARTMENT

STATESVILLE 704-878-5305 MOORESVILLE 704-664-5281

IMPROVEMENT PERMIT / AUTHORIZATION TO CONSTRUCT / OPERATION PERMIT / EXISTING SYSTEM INSPECTION

PERMIT# REPAIR PIN# 4737-46-4949 DATE 7-2-07

OWNER OR APPLICANT ROBERT W. BRICKLACHER PHONE: Business Home 704-876-8681

ADDRESS 121 PORTER ROAD STATESVILLE, NC 28625-2131

LOCATION NC 115 NORTH, TR SLIGHT STANLEY FORD ROAD, TR PORTER ROAD, 2ND HOUSE ON LEFT

SUBDIVISION PRESSLY BLOCK / SECTION LOT 3-4 LOT AREA 0.87 ACRE SITE CLASS PS DESIGN FLOW 360 L.T.A.R. 0.30 GPD/FT²

Septic Tank: EXISTING Gallons: STB Date

Pump Tank: Gallons: PT Date

Pump Make: Model Serial No.

Nitrification Field: No Fields 1 Square Feet EQUIV 720 Linear Feet 180

No Lines TWO Trench Width 36" Max Trench Bottom Depth 36"

☐ New System ☑ Repair ☐ Expansion System Type: I (II) III IV V VI

System Description:

Repair System Description: 25% REDUCTION GRAVITY

Maintenance Agreement Required: ☑ Yes ☑ No

Gravel Depth N/A ☑ Gravity ☐ Pressure

☑ House/Mod. Home No. Bedrooms 3

☐ Mobile Home No. Persons

☐ Business No. Employees

☐ Other


Water Supply: ☑ Individual ☑ Public ☐ Community

☐ Slab ☑ Crawl Space ☐ Basement w/plumbing ☐ Basement wo/plumbing

Comments:/Conditions: INSTALL NEW DISTRIBUTION BOX AT LOCATION SHOWN FEEDING TWO NEW 3'x90' LINES ON CONTOUR USING 25% REDUCTION SYSTEM. TO BE REPAIRED BY 8-2-07

Comments:/Conditions: REPAIR LINES INSTALLED UNNECESSARILY DEEP

INITIAL SITE SKETCH

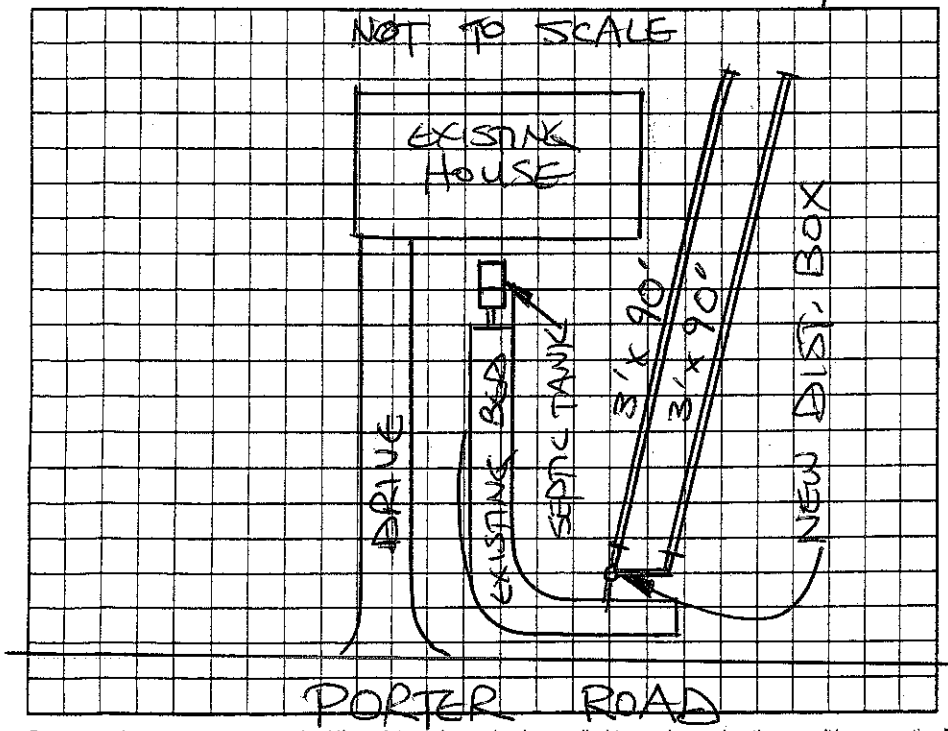

AS BUILT SKETCH

SYSTEM REPAIRED ACCORDING TO INITIAL SITE SKETCH

Permit can be suspended or revoked if any false information is supplied toward securing the permit/any unauthorized changes are made to the site/any unauthorized changes are made in the installation of the system. Improvement Permit with plat valid without expiration ☐ Improvement Permit with site plan valid for sixty months ☑ Authorization to Construct is valid for a period equal to that of Improvement Permit – not to exceed sixty months.

Signed: date 7/2/07 Installed by: JAMES HUGER

Improvement Permit by: STEVE HEDRICK date 7-2-07 Operation Permit by: STEVE HEDRICK date 7-10-07

Authorization to Construct by: STEVE HEDRICK date 7-2-07 Existing System Inspection by: date

HEALTH DEPT. COPY: WHITE OWNER COPY (FINAL): YELLOW OWNER COPY (INITIAL): PINK