PERMIT TO INSTALL SEPTIC TANK

Permit No. 70 Permit Date 11-13 19 72

Owner Ralph Foster Est Address Statesville NC

Installed By Lackey Bros Address Stony Point NC


Location of Property Out Cripple Ford Rd to Emily Acres T.R. on Foster Dr. 1st house on L.

Tank		Capacity		Length of Lines		Fixtures	
Block	( )	1000	(✓)	225'	(✓)	No. of Baths	(2)
Precast	(✓)	1250	( )	250'	( )	Dishwasher	( )
		1500	( )	Other		Garbage Grdr.	( )
		Other				Other	

NOTIFY HEALTH DEPARTMENT AT LEAST EIGHT HOURS BEFORE TANK IS TO BE INSPECTED.

Final Inspection 11-13 1972 Approved (✓) Disapproved ( )

Remarks Community Water

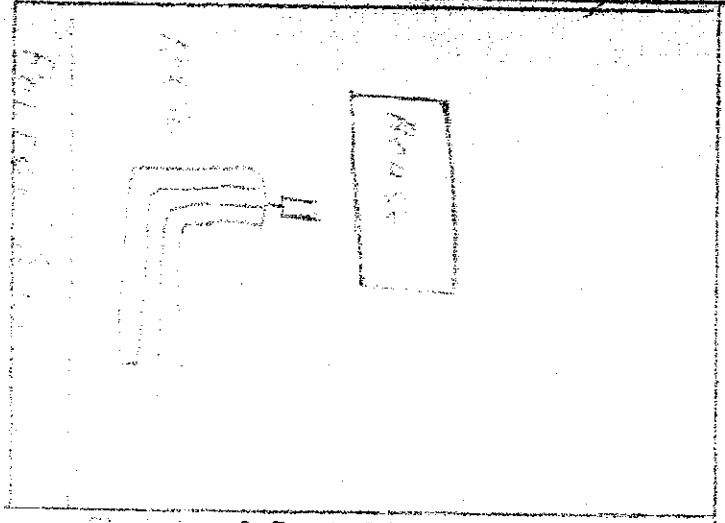

Sketch of Installation

E. G. [illegible]

Sanitarian

JAN. 10, 1989 20:38