IREDELL COUNTY HEALTH DEPARTMENT

STATESVILLE 704-878-5305 MOORESVILLE 704-664-5281 (C1)

IMPROVEMENT PERMIT / AUTHORIZATION TO CONSTRUCT / OPERATION PERMIT / EXISTING SYSTEM INSPECTION

PERMIT# 118154 PIN# 4737-46-6591 DATE 1-6-09

OWNER OR CONTRACTOR WAYNE HOMES MID-ATLANTIC LLC PHONE: Business 704-872-0271 (14) Home 336-782-9262

ADDRESS 130 VICTORY LANE, STATESVILLE NC 28677

LOCATION NC 115 N TR 5. CHIPLEY FORD RD, TR PRATT LANE 8TH LOT ON LEFT AT BOX #145

SUBDIVISION PRESSLEY ACRES BLOCK / SECTION ____ LOT 24 LOT AREA 0.48 ACRE SITE CLASS. PS DESIGN FLOW 360 L.T.A.R. EXISTING

Septic Tank: 1000 Gallons; STB ____ Date ____

Pump Tank: ____ Gallons; PT ____ Date ____

Pump Make: ____ Model ____ Serial No. ____

Nitrification Field: No Fields 1 Square Feet 810 Linear Feet 84

No Lines 1 BED Trench Width 9' Max Trench Bottom Depth ____ Gravel Depth 10"

☐ New System ☐ Repair System Type: I, (II), III, IV, V, VI

System Description: CONVENTIONAL, GRAVITY

Repair System Description: ____

Maintenance Agreement Required: ☐ Yes ☒ No

☒ House/Mod. Home No. Bedrooms 3

☐ Mobile Home No. Bathrooms 2

☐ Business No. Employees ____

☐ Other ____


☐ Slab ☒ Crawl Space ☐ Basement w/plumbing ☐ Basement wo/plumbing

Water Supply: ☐ Individual ☒ Public ☐ Community


Comments:/Conditions:

Comments:/Conditions: SYSTEM UNDERSIZED ACCORDING TO TODAY'S STANDARD REPLACING BURNED-OUT HOUSE

INITIAL SITE SKETCH

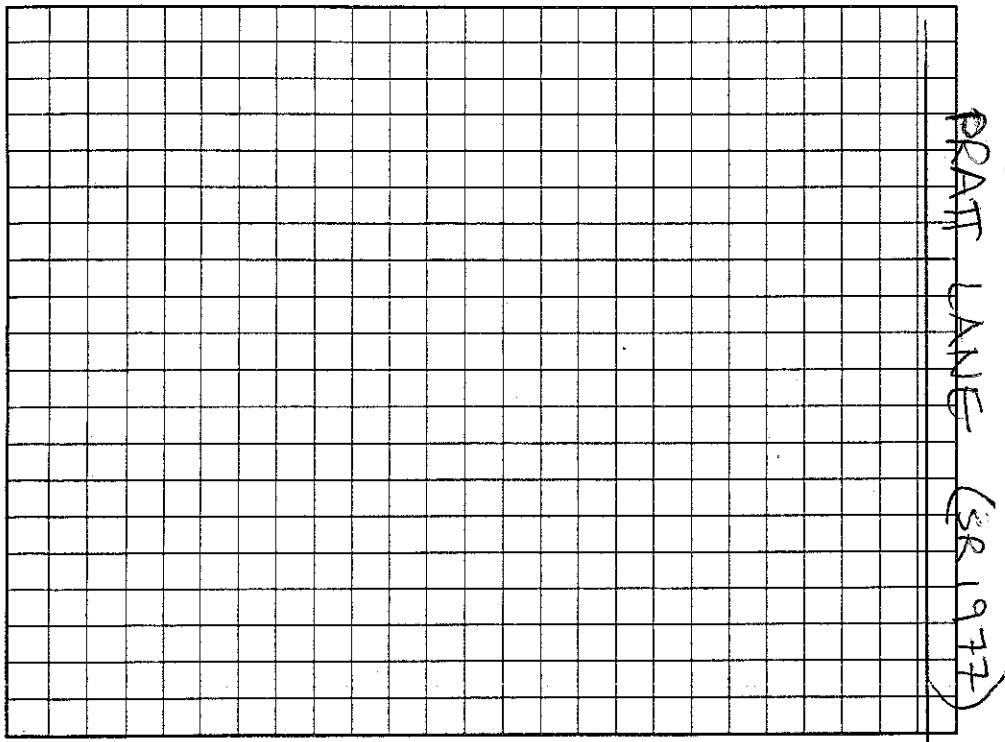

AS BUILT SKETCH

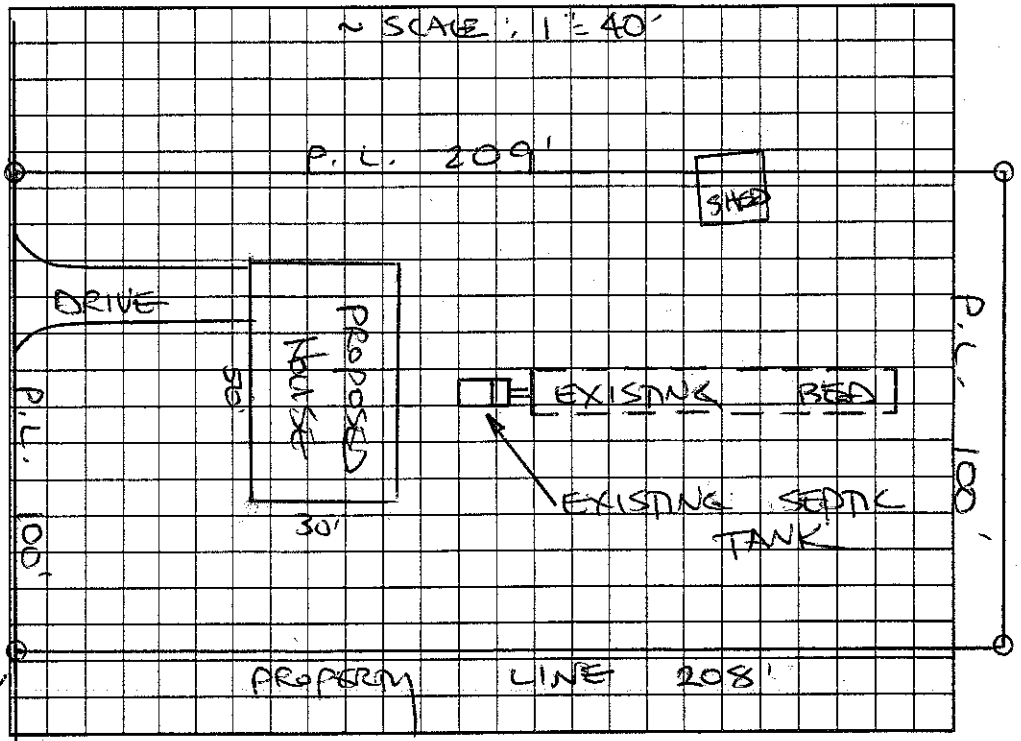

Permit can be suspended or revoked if any false information is supplied toward securing the permit/any unauthorized changes are made to the site/any unauthorized changes are made in the installation of the system. Improvement Permit with plat valid without expiration. Improvement Permit with site plan valid for sixty months. Authorization to Construct is valid for a period equal to that of Improvement Permit – not to exceed sixty months.

Signed: ____ date ____

Improvement Permit by: ____ date ____

Authorization to Construct by: ____ date ____

Installed by: ____

Operation Permit by: ____ date ____

Existing System Inspection by: STEVE HEDRICK date 1-6-09

HEALTH DEPT. COPY: WHITE OWNER COPY (FINAL): YELLOW OWNER COPY (INITIAL): PINK