IREDELL COUNTY HEALTH DEPARTMENT

Statesville Phone TR 3-7271 Mooresville Phone NO 3-1271

PERMIT TO INSTALL SEPTIC TANK

Permit No. 33 Permit Date 6-29 19 71

Owner Bldr. FLAKE PRATT Address STATESVILLE.

Installed By ADAMS Address TAYLORSVILLE, NC.

Location of Property PRESSLEY ACRES.

ON CHIPLEY FORD RD - ON RIGHT PAST


SMITH WHITES STORE -

Tank		Capacity		Length of Lines		Fixtures	
Block	( )	1000	(✓)	225'	(✓)	No. of Baths	(1)
Precast	(✓)	1250	( )	250'	( )	Dishwasher	( )
		1500	( )	Other		Garbage Grdr.	( )
		Other				Other	

NOTIFY HEALTH DEPARTMENT AT LEAST EIGHT HOURS BEFORE TANK IS TO BE INSPECTED.

Final Inspection 6-29 1971 Approved (✓) Disapproved ( )

Remarks NO WATER SUPPLY AT TIME OF INSP.

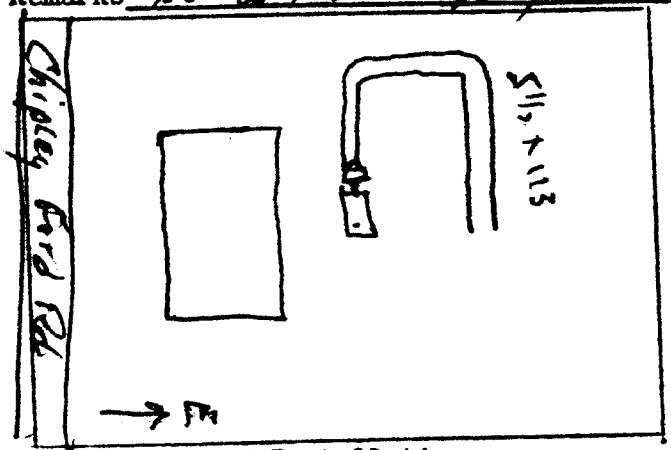

Sketch of Installation

Sanitarian