IREDELL COUNTY HEALTH DEPARTMENT

Statesville Phone TR 3-7271 Mooresville Phone NO 3-1271

PERMIT TO INSTALL SEPTIC TANK

Permit No. 33 Permit Date 6 - 29 1971

Owner Bldr. FLAKE Pratt Address STATESVILLE.

Installed By Adams Address Taylorsville, NC.

Location of Property PRESSLEY ACRES.

ON Chipley Ford Rd - on RIGHT PAST


Smith Whites Store -

Tank		Capacity		Length of Lines		Fixtures	
Block	( )	1000	(✓)	225'	(✓)	No. of Baths	(✓1)
Precast	(✓)	1250	( )	250'	( )	Dishwasher	( )
		1500	( )	Other		Garbage Grdr.	( )
		Other				Other	

NOTIFY HEALTH DEPARTMENT AT LEAST EIGHT HOURS BEFORE TANK IS TO BE INSPECTED.

Final Inspection 6 - 29 1971 Approved (✓) Disapproved ( )

Remarks NO WATER SUPPLY AT TIME OF INSP.

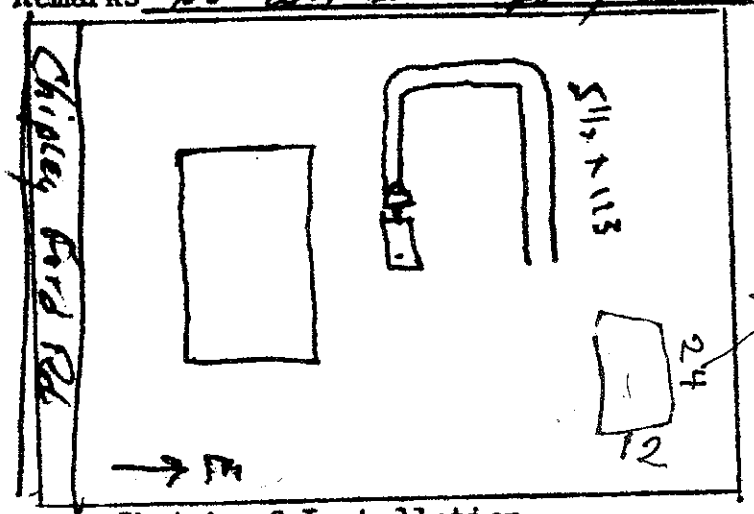

Sketch of Installation

The location of the proposed Storage building addition does not appear to impact the existing septic system. **NOTE:

REHS

Date: 5-2-11

ICHD-Environmental Health Division

storage building

Sanitarian