IREDELL COUNTY HEALTH DEPARTMENT

STATESVILLE 704-878-5305 MOORESVILLE 704-664-5281

IMPROVEMENT PERMIT / AUTHORIZATION TO CONSTRUCT / OPERATION PERMIT / EXISTING SYSTEM INSPECTION

PERMIT # R2001R PIN # 4737-53-0225 DATE 22 Apr 10

OWNER or APPLICANT James Hobbs PHONE: Business cell (704)-657-3330 Home:

OWNER or APPLICANT ADDRESS 610 Ingram Rd. Statesville

LOCATION / DIRECTIONS Chipley Ford off TR Ingram Rd. - 1/4 mile ± on Left.

SUBDIVISION BLOCK / SECTION LOT # LOT AREA 5.17 ac DESIGN FLOW 360 gpd L.T.A.R. 0.3/1.2

Septic Tank Ex. 1,250 Gallons: STB Date

Pump Tank Gallons: P T Date

Pump Make Model Serial # Cast

Nitrification Field No Fields 1 No Lines 2 Linear Feet ~~300~~ 200

Trench Width 36 Max. Trench Bottom Depth 36 Gravel Depth N/A

☐ New System ☑ Repair ☐ Expansion System Type I II III IV V VI

System Description:

Repair System Description: 25% Reduction

Maintenance Agreement Required ☐ YES ☑ NO

☑ GRAVITY ☐ PRESSURE

☑ Residence No. Bedrooms 3

☐ Business No. Persons

☐ Other No. Employees

☐ Slab ☐ Crawl Space


☑ Basement w/plumbing ☐ Basement w/o plumbing

Water Supply: ☑ Private ☐ Public ☐ Community


Comments / Conditions Add 240 lf. to existing system.

Comments / Conditions

INITIAL SITE SKETCH

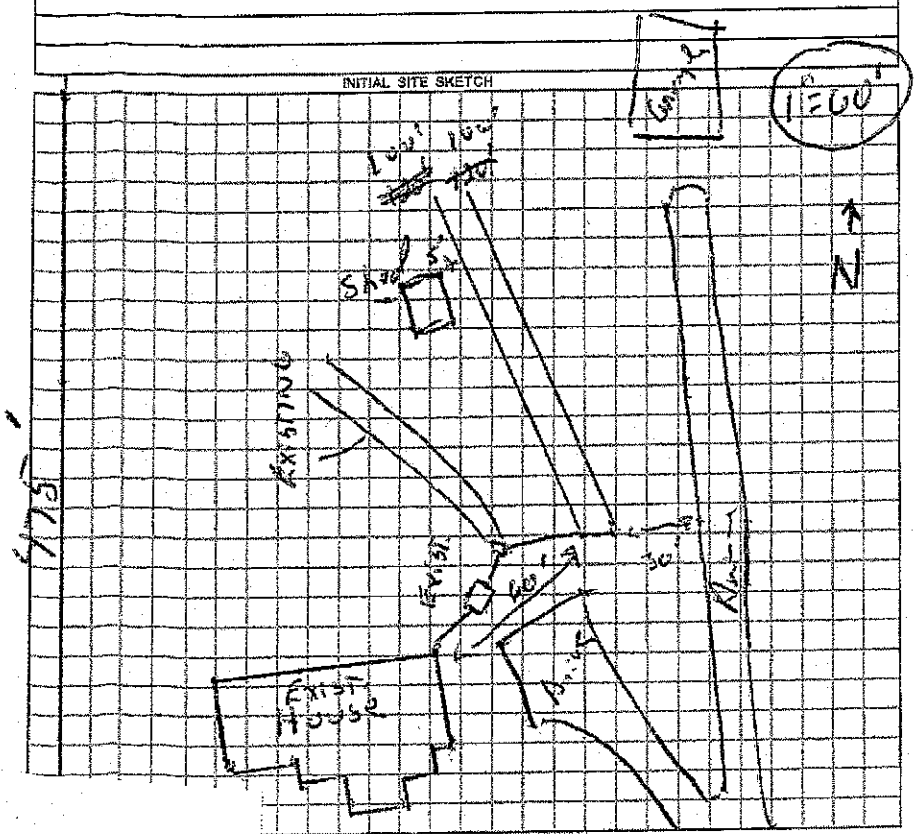

AS BUILT SKETCH

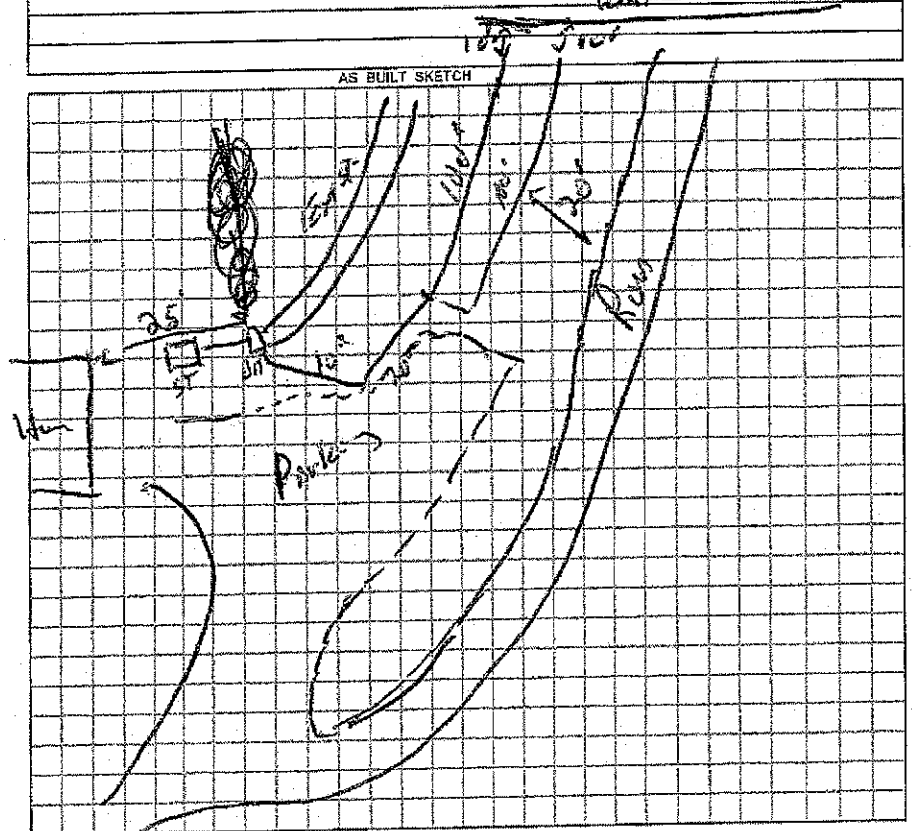

Permit may be revoked if any false information is supplied toward securing the permit / any unauthorized changes are made to the site / any unauthorized changes are made in the installation of the system.

☐ *IMPROVEMENT PERMIT w / site plan valid for 60 mos.* ☑ *AUTHORIZATION TO CONSTRUCT valid for period equal to IMPROVEMENT PERMIT-not to exceed 60 mo.*

IMPROVEMENT PERMIT w / plat valid without expiration.

Date 23 Apr 10


Date

Operation Permit by: R.S. Date: 30 Apr 10

R.S. Date 22 Apr 10

Existing System Inspected by: Date:

CONTACT A LOCATOR SERVICE PRIOR TO ANY EXCAVATION.

WHITE COPY Environmental Health YELLOW COPY (Final) Owner / Applicant PINK COPY (Initial) Owner / Applicant