IREDELL COUNTY HEALTH DEPARTMENT STATESVILLE 704-878-5305 MOORESVILLE 704-664-5281

IMPROVEMENT PERMIT / AUTHORIZATION TO CONSTRUCT / OPERATION PERMIT / EXISTING SYSTEM INSPECTION

PERMIT # Repair PIN # 4737-53-0225 DATE 22 Apr 10

OWNER or APPLICANT James Hobbs PHONE: ~~Business~~ Cell (704)-657-3330 Home:

OWNER or APPLICANT ADDRESS 610 Ingram Rd. Statesville

LOCATION / DIRECTIONS Chipley Ford Rd. TR Ingram Rd. - 1/4 mile 1 on Left.

SUBDIVISION BLOCK / SECTION LOT # LOT AREA 5.17 ac. DESIGN FLOW 360 g/d L.T.A.R. 0.3 g/ft²/d

Septic Tank Exist. Gallons: STB Date

Pump Tank Gallons: PT Date

Pump Make Model Serial #

Nitrification Field No Fields 1 No Lines 2 Linear Feet ~~240~~ 200

Trench Width 36 Max. Trench Bottom Depth 36 Gravel Depth NA

☐ New System ☑ Repair ☐ Expansion System Type I II (III) IV V VI

System Description:

Repair System Description: 25% Reduction

Maintenance Agreement Required ☐ YES ☑ NO

☑ GRAVITY ☐ PRESSURE

☑ Residence No. Bedrooms 3

☐ Business No. Persons

☐ Other No. Employees

☐ Slab ☐ Crawl Space


☑ Basement w/plumbing ☐ Basement w/o plumbing

Water Supply ☑ Private ☐ Public ☐ Community


Comments / Conditions Add 240 lf. to existing system.

Comments / Conditions

INITIAL SITE SKETCH

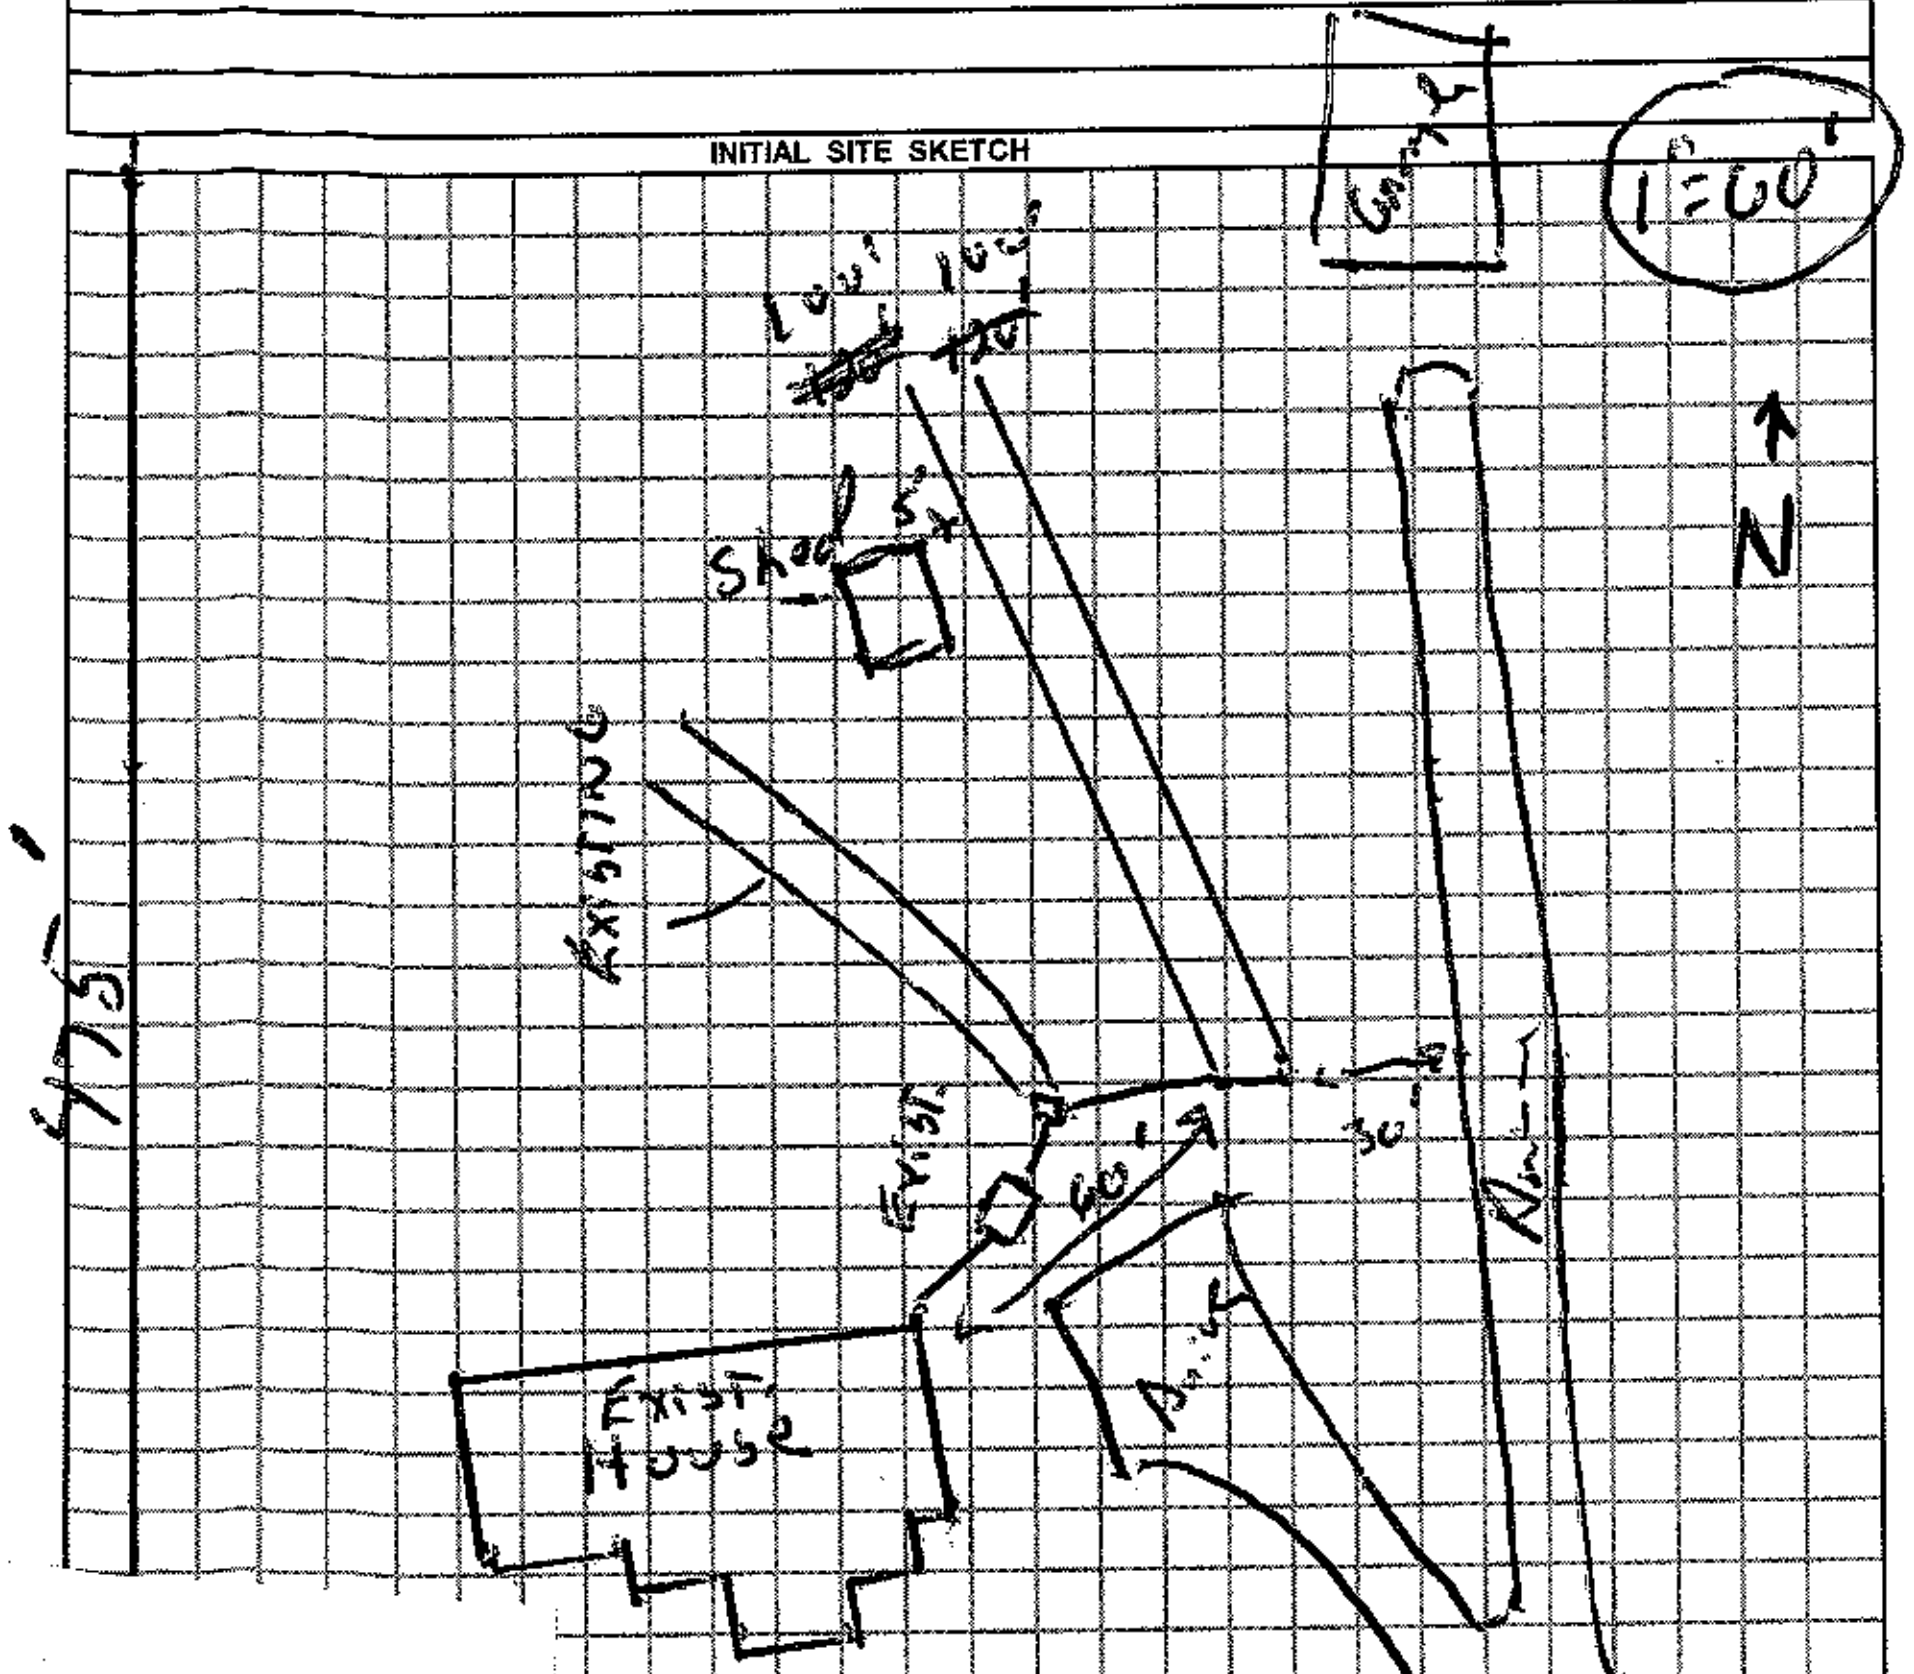

AS BUILT SKETCH

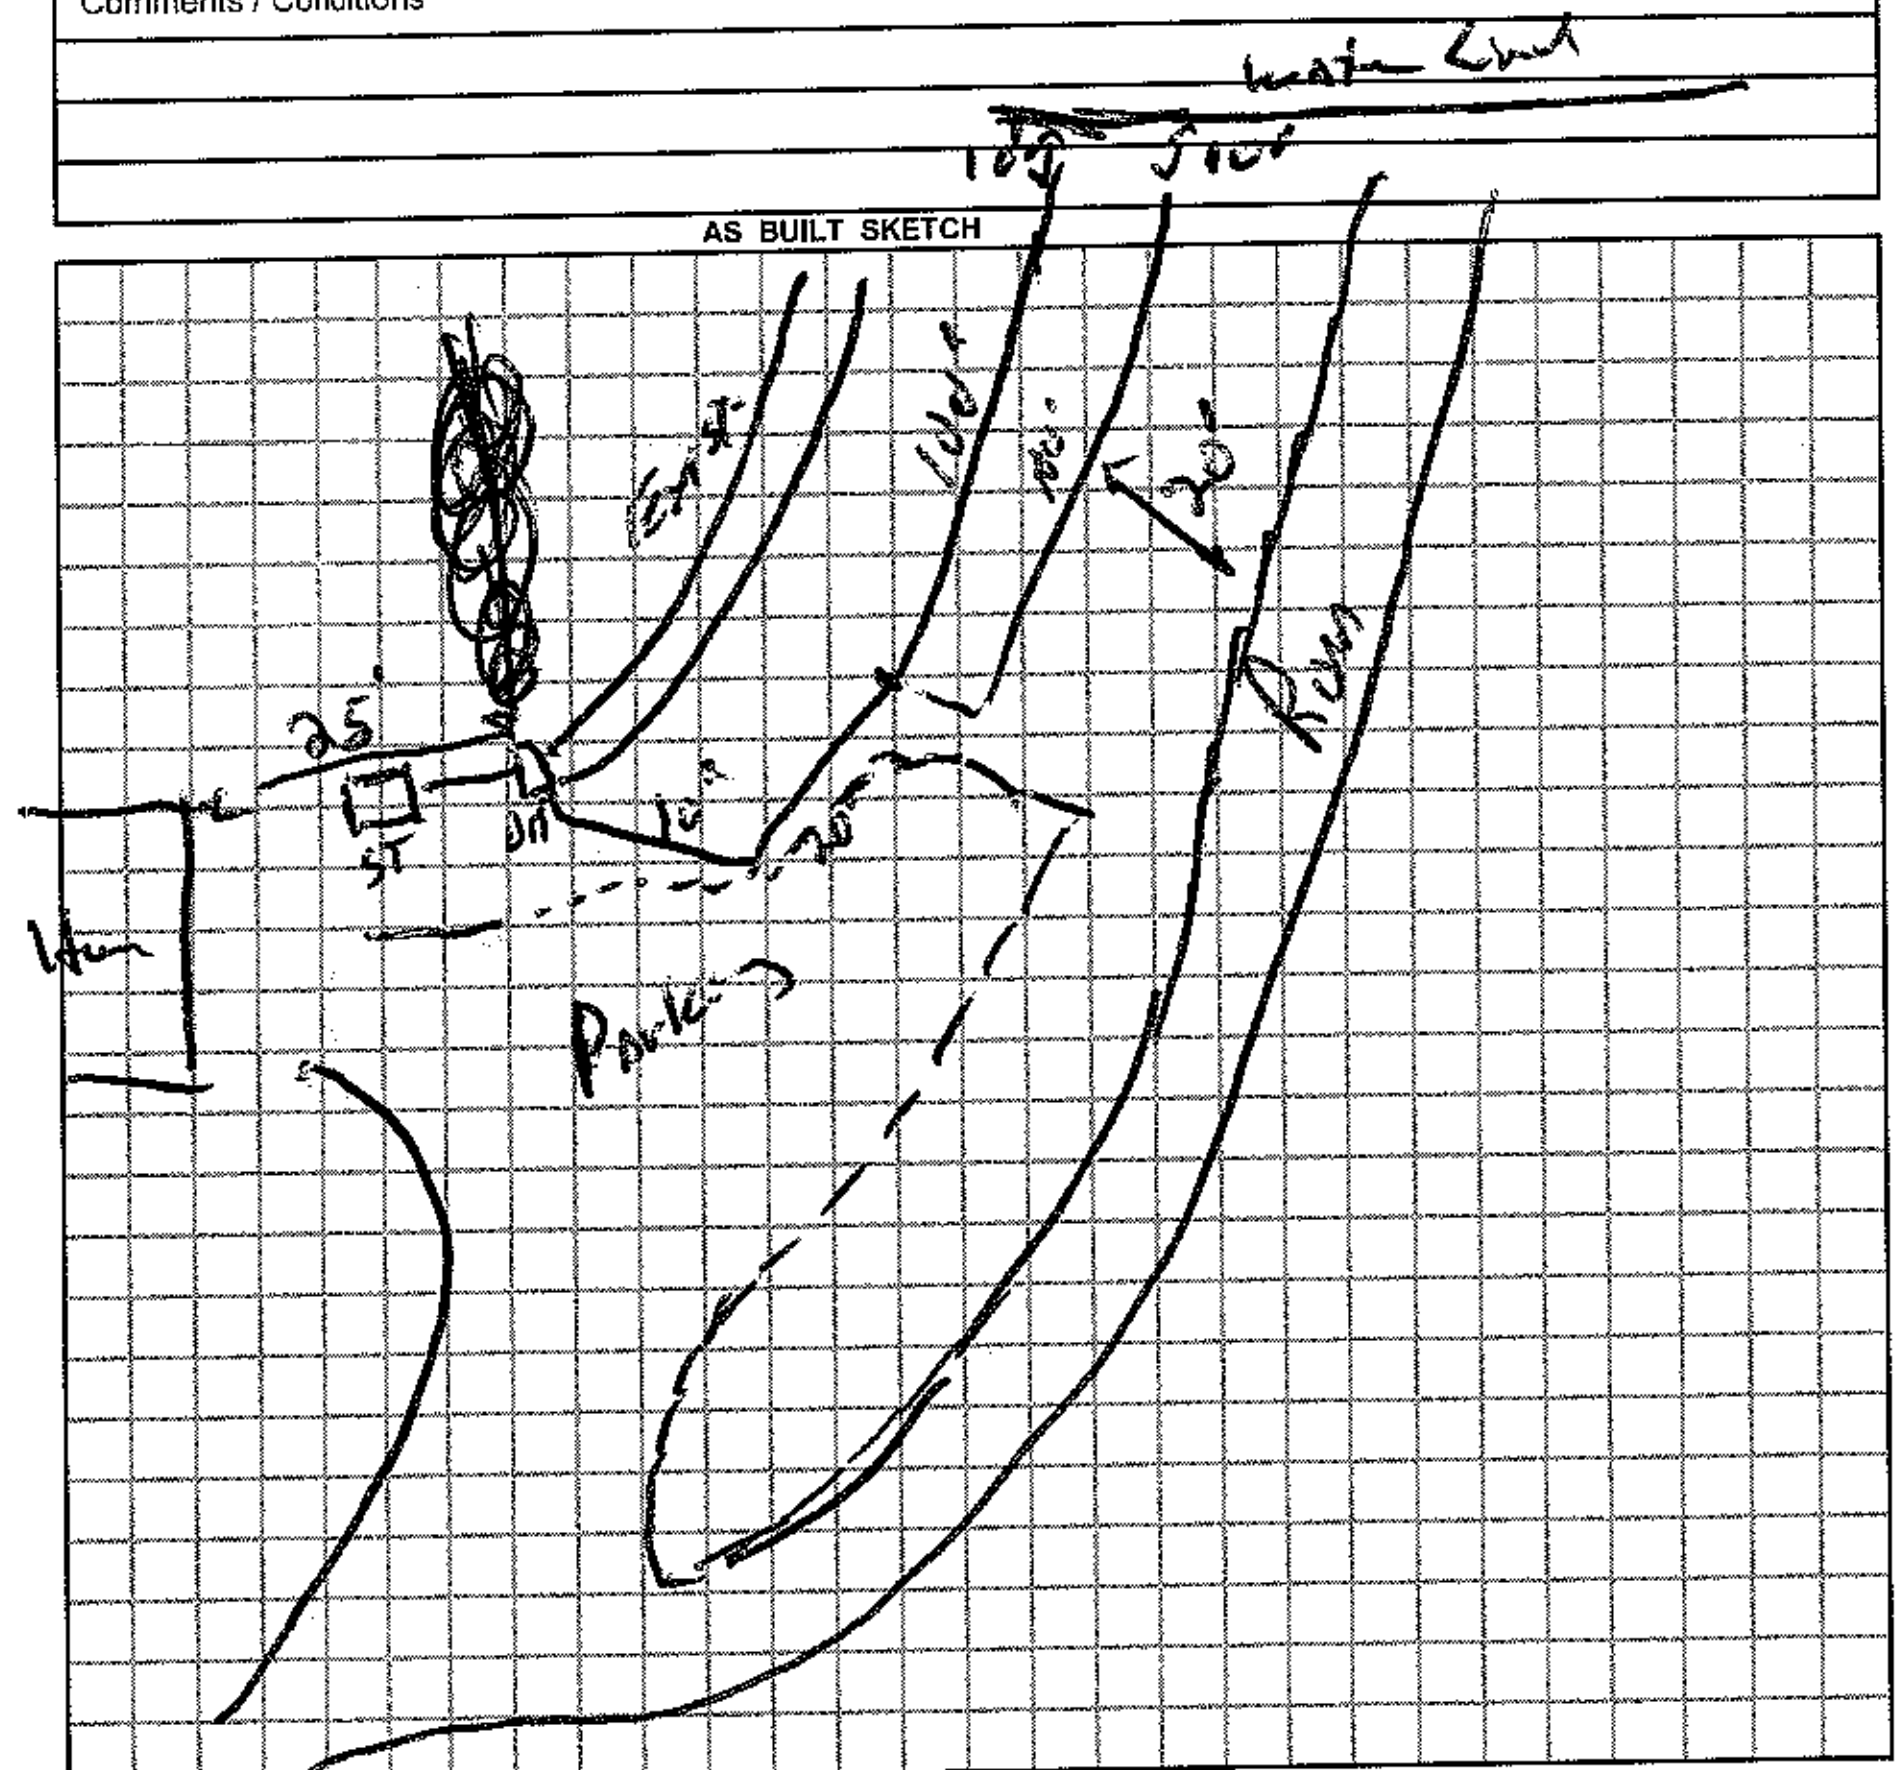

...oked if any false information is supplied toward securing the permit / any unauthorized changes are made to the site / any unauthorized changes are made in the installation of the system.

...w / plat valid without expiration. ☐ IMPROVEMENT PERMIT w / site plan valid for 60 mos. ☑ AUTHORIZATION TO CONSTRUCT valid for period equal to IMPROVEMENT PERMIT-not to exceed 60 mo.

[signature] Date 23 Apr 10

Date

[signature], R.S. Date 22 Apr 10

...ACT A LOCATOR SERVICE PRIOR TO ANY EXCAVATION.

Installed by: Dolly Madison

Operation Permit by: [signature], R.S. Date: 30 Apr 10

Existing System Inspected by: Date:

WHITE COPY Environmental Health YELLOW COPY (Final) Owner / Applicant PINK COPY (Initial) Owner / Applicant