4737-53-5036

IREDELL COUNTY HEALTH DEPARTMENT

STATESVILLE 704-878-5305 MOORESVILLE 704-664-5281

IMPROVEMENT PERMIT / AUTHORIZATION TO CONSTRUCT / OPERATION PERMIT / EXISTING SYSTEM INSPECTION

PERMIT# 143126 PIN# 4737-63-0030 4737-52-4851 DATE 8-15-07

OWNER OR APPLICANT JEREMIAH & TARA BEATTY PHONE: Business 704-902-2048 Home 704-876-3454

ADDRESS 136 BARRINGER DRIVE, STATESVILLE, NC 28625

LOCATION US 21 NORTH, TL SHUMAKER ROAD, TL INGRAM ROAD, 1.9 MILES ON RIGHT 300' BACK off ROAD

SUBDIVISION _____ BLOCK / SECTION _____ LOT 1 LOT AREA 5.407 Acres SITE CLASS. PS DESIGN FLOW 480 L.T.A.R. 0.30 GPD/FT²

Septic Tank: 1000 Gallons: STB 1082 Date 4-4-07

Pump Tank: _____ Gallons: PT _____ Date _____

Pump Make: _____ Model _____ Serial No. _____

Nitrification Field: No Fields 1 Square Feet 1600 Linear Feet 400

No Lines FIVE Trench Width 36" Max Trench Bottom Depth 32"

☑ New System ☐ Repair ☐ Expansion System Type: I (II) III IV V VI

System Description: 25% REDUCTION, GRAVITY

Repair System Description: CONVENTIONAL, PUMP

Maintenance Agreement Required: ☐ Yes ☑ No

☑ House/Mod. Home No. Bedrooms 4

☐ Mobile Home No. Persons _____

☐ Business No. Employees _____

☐ Other (3BR INITIALLY)


Water Supply: ☐ Individual ☑ Public ☐ Community

Gravel Depth N/A ☑ Gravity ☐ Pressure ☐ Slab ☐ Crawl Space ☑ Basement w/plumbing ☐ Basement wo/plumbing


Comments/Conditions: INSTALL 25% REDUCTION SYSTEM ON CONTOUR AS FLAGGED ON SITE, NO DEEPER THAN 32 INCHES

Comments/Conditions:

INITIAL SITE SKETCH

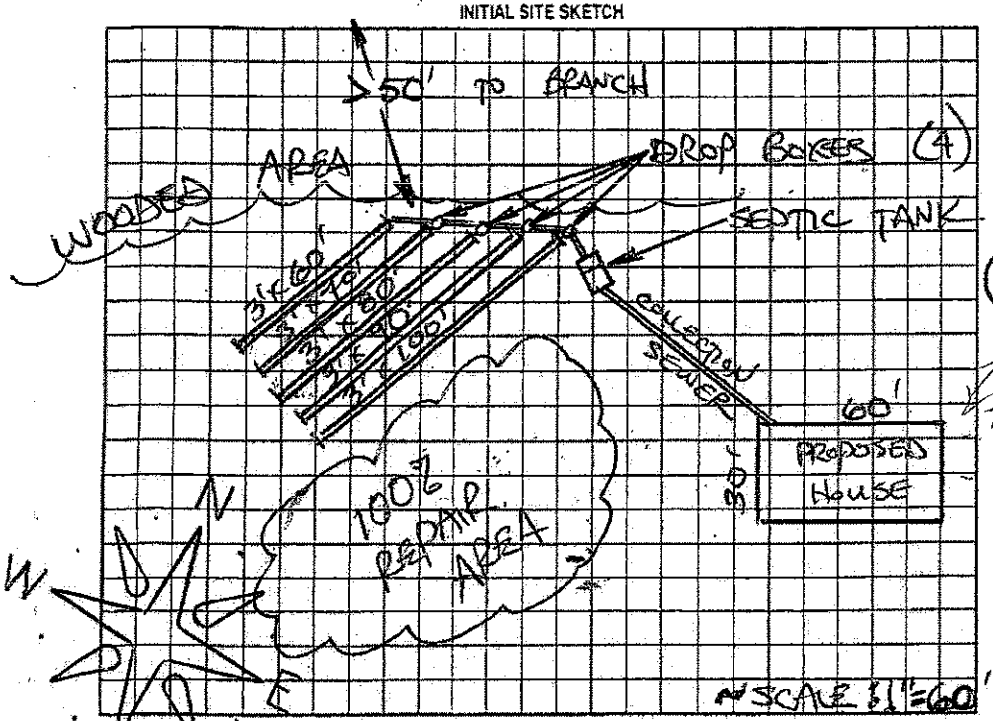

AS BUILT SKETCH

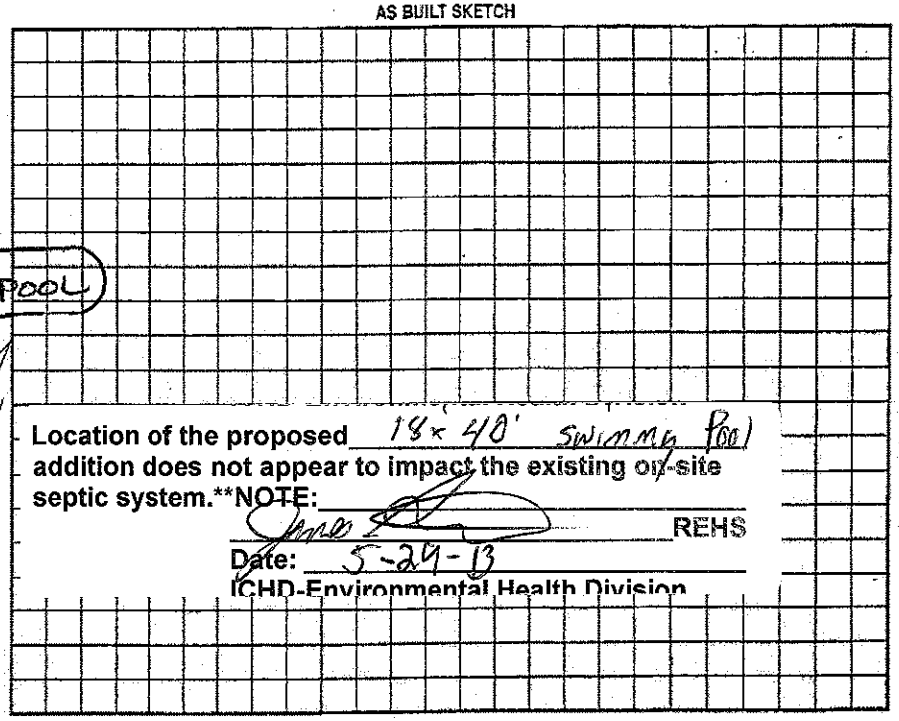

Location of the proposed 18x40' swimming Pool addition does not appear to impact the existing on-site septic system.NOTE:** _____ REHS

Date: 5-29-13

ICHD-Environmental Health Division

Permit can be suspended or revoked if any false information is supplied toward securing the permit/any unauthorized changes are made to the site/any unauthorized changes are made in the installation of the system. Improvement Permit with plat valid without expiration ☐ Improvement Permit with site plan valid for sixty months ☑ Authorization to Construct is valid for a period equal to that of Improvement Permit – not to exceed sixty months.

Signed: Dana A Beatty date 8-15-07 Installed by: Steve Jordan

Improvement Permit by: STEVE HENDRICK date 8-15-07 Operation Permit by: _____ date 1-6-10

Authorization to Construct by: STEVE HENDRICK date 8-15-07 Existing System Inspection by: _____ date _____

HEALTH DEPT. COPY: WHITE OWNER COPY (FINAL): YELLOW OWNER COPY (INITIAL): PINK