($150.00 Paid ~~$160.00~~ M.B.) 12:30 61936

IREDELL COUNTY HEALTH DEPARTMENT

STATESVILLE 704-878-5305 MOORESVILLE 704-664-5281

IMPROVEMENT PERMIT / CERTIFICATE OF COMPLETION / OPERATION PERMIT / EXISTING SYSTEM INSPECTION

PROPERTY DESCRIPTION NO. 23781 DATE 5-31-96 TAX MAP NO. 10E-1-0-35 Watershed: ☐ Yes ☑ No

OWNER OR CONTRACTOR Bruce Geiger PHONE: Business _____ Home _____

ADDRESS 410 Hartness Rd Statesville

LOCATION Chipley Ford Rd TR Potter St 1/8 mi rt

SUBDIVISION ~~Potter St~~ Pressley Acres BLOCK/SECTION _____ LOT 10+11 LOT AREA 210X200' SITE CLASS PS DESIGN FLOW 360 L.T.A.R. .25

Septic Tank: 1000 Gallons; STB 1013 Date 5-12-96 ☑ New System ☐ Repair System Type: I, II, III, IV, V, VI ☑ House/Mod. Home No. Bedrooms 3

Pump Tank: 1000 Gallons; PT 17 Date 10-8-96 System Description: Pump To Chambers ☐ Mobile Home No. Bathrooms 2½

Pump Make: Hydromatic Model SCM-1 Serial No. 5186T-CCC-1 Repair System Description: " " " ☐ Business No. Employees ____

Nitrification Field: No Fields 1 Square Feet 1080 Linear Feet 360 Maintenance Agreement Required: ☐ Yes ☑ No ☐ Other ____


No Lines 4 Trench Width 36" Max Trench Bottom Depth 36" Gravel Depth N/A ☐ Slab ☐ Crawl Space ☑ Basement w/plumbing ☐ Basement wo/plumbing

Water Supply: ☐ Individual ☐ Community ☑ Public

Comments:
See Attached Sheets for Pump Tank Set up Pressure manifold & Clean out which are part of this permit

Comments:
Drain lines Pump & Pump T. Draw Down Test Etc. Checked 11-27-96 JCM

INITIAL SITE SKETCH 210'

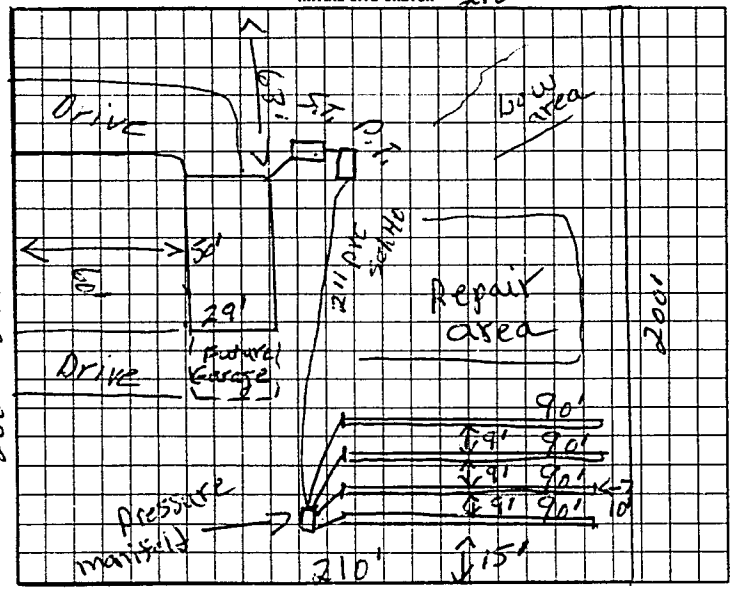

AS BUILT SKETCH

Same as initial sketch

I understand that this permit can be suspended or revoked if any false information is supplied toward securing the permit/any unauthorized changes are made to the site/any unauthorized changes are made in the installation of the system.

Signed: Bruce W. Geiger

Improvement Permit by: L.C. Moore date 5-31-96

~~Authorization~~ Existing System Inspection by: L.C. Moore date 5-31-96

to cont.

Installed by: Tommy Cothren

Certificate of Completion by: _____ date _____

Operation Permit by: L.C. Moore date 12-18-96

HEALTH DEPT COPY WHITE | INSPECTION COPY (FINAL) GREEN | OWNER COPY (FINAL) YELLOW | INSPECTION COPY (INITIAL) PINK | OWNER COPY (INITIAL) GOLD

Authorization to cont. Expires 60 mos from issue

0 0 0 0 0