IREDELL COUNTY HEALTH DEPARTMENT - *ENVIRONMENTAL HEALTH* ☐ STATESVILLE OFFICE 704-878-5305 ☐ MOORESVILLE OFFICE 704-664-5281

IMPROVEMENT PERMIT / AUTHORIZATION TO CONSTRUCT / OPERATION PERMIT / EXISTING SYSTEM INSPECTION

PERMIT # REPAIR PIN # 4737-56-2677 DATE JULY 29, 2011

OWNER JUSTIN C. ELAM APPLICANT: SAME PHONE: Home/Cell # c/o 704-902-9229 Business # 704-902-4154

SITE ADDRESS 160 PORTER LANE, STVL, NC OWNER / APPLICANT ADDRESS 139 McALISTER ROAD, STATESVILLE 28625

SITE DIRECTIONS SOUTH CHIPLEY FORD ROAD TO PORTER LANE, HOUSE ON RIGHT AT BOX #160

SUBDIVISION PRESSLEY ACRES BLOCK / SECTION LOT # 37 LOT AREA 0.485 AC DESIGN FLOW 360 L.T.A.R. EXISTING

Septic Tank 1000 Gallons: STB 1012 Date 5-11 ☐ New System ☑ Repair ☐ Expansion System Type I (II) III IV V VI ☑ Residence No. Bedrooms 3 Water Supply

Pump Tank ____ Gallons: P T ____ Date ____ System Description: ☐ Business No. Persons ____ ☐ Private

Pump Make ____ Model ____ Serial # ____ Repair System Description: TANK - CONVENTIONAL ☐ Other No. Employees ____ ☑ Public


No. Nitrification Fields: 1 No. Lines 1 - BED linear Feet EX Maintenance Agreement Required ☐ YES ☑ NO ☐ Slab ☐ Crawl Space ☐ Community

Trench Width EX Max. Trench Bottom Depth EX Gravel Depth EX ☑ GRAVITY ☐ PRESSURE ☐ Basement w/plumbing ☐ Basement w/o plumbing


Comments / Conditions CRUSH & FILL EXISTING SEPTIC TANK & INSTALL NEW SEPTIC TANK AS SHALLOW AS POSSIBLE; USING RISERS TO ALLOW ACCESS WITHIN 6 INCHES OF GROUND SURFACE.

Polylock Fittings

INITIAL SITE SKETCH

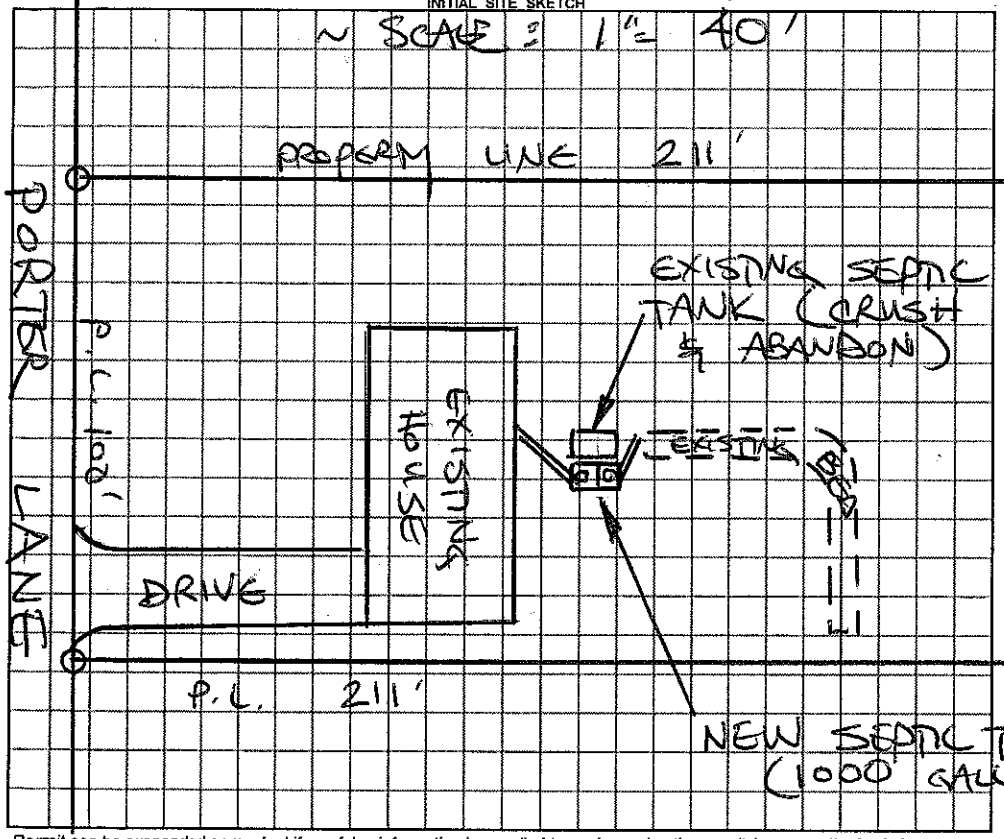

AS BUILT SKETCH

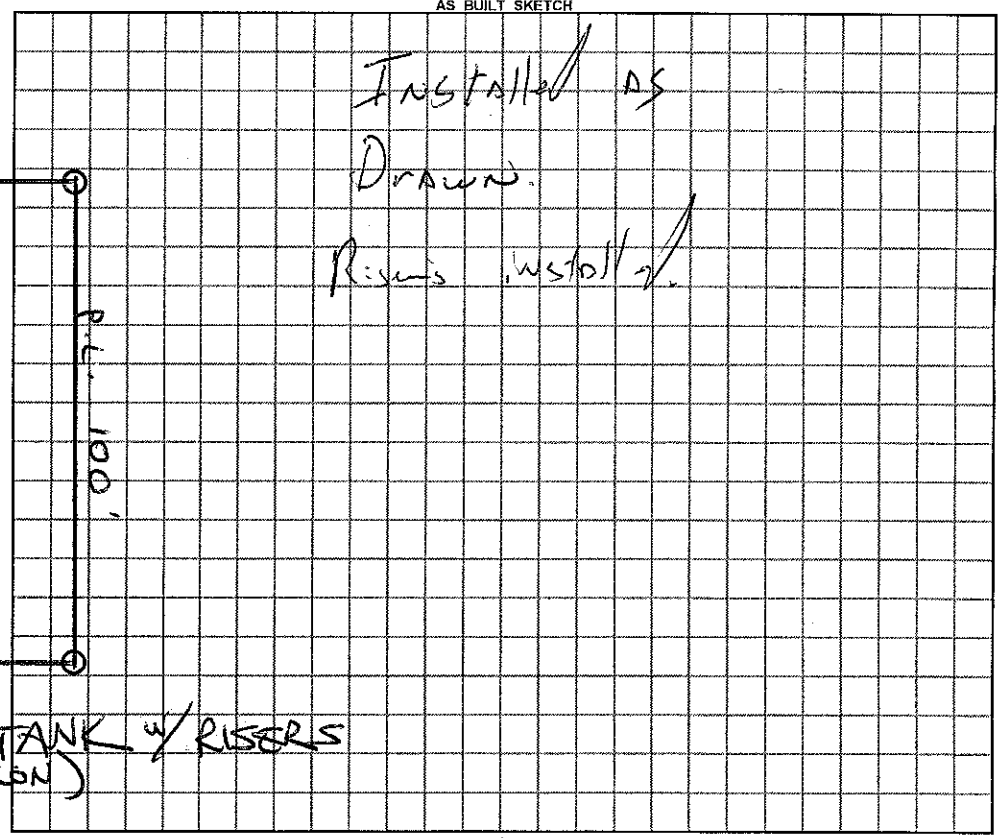

Permit can be suspended or revoked if any false information is supplied toward securing the permit / any unauthorized changes are made to the site / any unauthorized changes are made in the installation of the system.

☐ ***IMPROVEMENT PERMIT*** with plat valid without expiration. ☑ ***IMPROVEMENT PERMIT*** with ~~plat valid without expiration~~ site plan valid 60 mo. ☑ ***AUTHORIZATION TO CONSTRUCT*** valid for period equal to IMPROVEMENT PERMIT--not to exceed 60 mo.

Owner / Applicant Signature: Justin Elam Date 7/29/11 Installed by: GUNTER GRADING

IMPROVEMENT PERMIT by: STEVE HEDRICK REHS Date 7-29-11 OPERATION PERMIT by: REHS Date 15 AUG. 11

AUTHORIZATION TO CONSTRUCT by: STEVE HEDRICK REHS Date 7-29-11 Existing System Inspected by: REHS Date ____

YOU SHOULD CONTACT A LOCATOR SERVICE PRIOR TO ANY EXCAVATION

White Copy – Environmental Health YELLOW COPY (Final) Owner / Applicant PINK COPY (Initial) Owner / Applicant