IREDELL COUNTY HEALTH DEPARTMENT

STATESVILLE 704-878-5305 (a) MOORESVILLE 704-664-5281

IMPROVEMENT PERMIT / AUTHORIZATION TO CONSTRUCT / OPERATION PERMIT / EXISTING SYSTEM INSPECTION

PERMIT# 106191 PIN# 4737-65-1656 DATE 6-7-02

OWNER OR CONTRACTOR WILLIAM N. HAWKS PHONE: Business Home 704-876-0854

ADDRESS 118 PERSIMMON CIRCLE, HICKORY, NC 28624

LOCATION NC 115 N, TR S. CHIPLEY FORD, TR INGRAM ROAD, TL BEATTY FARM ROAD, NEAR END ON LEFT

SUBDIVISION BLOCK / SECTION LOT LOT AREA 34 ACRES SITE CLASS. PS DESIGN FLOW 360 L.T.A.R. 0.50 GPD/FT²

Septic Tank: 1000 Gallons; STB 1007 Date 8-17-04

Pump Tank: Gallons; PT Date

Pump Make: Model Serial No.

Nitrification Field: No Fields 1 Square Feet 720 Linear Feet 240

No Lines FOUR Trench Width 36" Max Trench Bottom Depth 36" Gravel Depth 12"

☑ New System ☐ Repair System Type: I (II) III IV V VI

System Description: CONVENTIONAL GRAVITY

Repair System Description: CONV. GRAVITY

Maintenance Agreement Required: ☐ Yes ☑ No

☑ House/Mod. Home No. Bedrooms 3

☐ Mobile Home No. Bathrooms 3

☐ Business No. Employees

☐ Other

☐ Slab ☐ Crawl Space ☑ Basement w/plumbing ☐ Basement wo/plumbing


Water Supply: ☑ Individual ☐ Public ☐ Community

WELL

Comments:/Conditions: KEEP SYSTEM MINIMUM 100 FEET FROM WELL

Comments:/Conditions: SEPTIC TANK WITH MARKER INSTALLED USING "ZABEL" FILTER

INITIAL SITE SKETCH

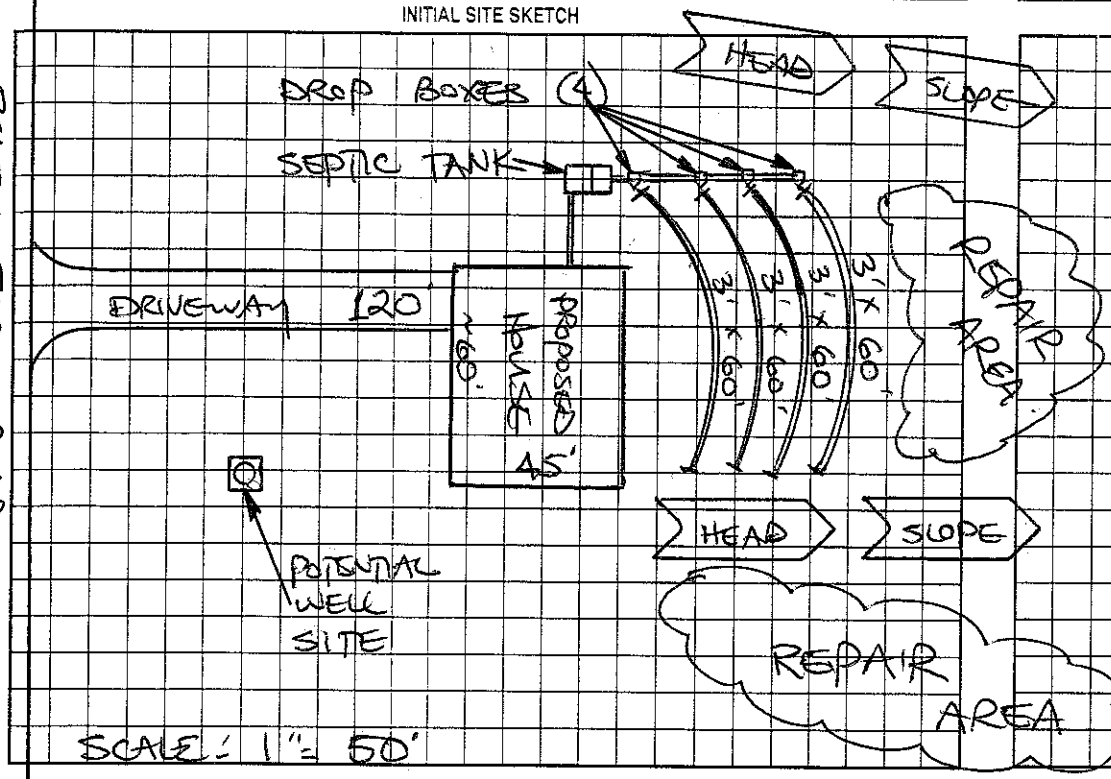

AS BUILT SKETCH

SYSTEM INSTALLED ACCORDING TO INITAL SITE SKETCH

Permit can be suspended or revoked if any false information is supplied toward securing the permit/any unauthorized changes are made to the site/any unauthorized changes are made in the installation of the system. Improvement Permit with plat valid without expiration. Improvement Permit with site plan valid for sixty months. Authorization to Construct is valid for a period equal to that of Improvement Permit – not to exceed sixty months.

Signed: Teresa Hawks date 10-7-02 Installed by: KELLY WELLBORNE

Improvement Permit by: STEVE HEDRICK date 6-7-02 Operation Permit by: STEVE HEDRICK date 10-19-04

Authorization to Construct by: STEVE HEDRICK date 6-7-02 Existing System Inspection by: date

HEALTH DEPT. COPY: WHITE OWNER COPY (FINAL): YELLOW OWNER COPY (INITIAL): PINK