IREDELL COUNTY HEALTH DEPARTMENT

Statesville Office (704) 878-5305 Mooresville Office (704) 660-3625 PERMIT # 212511

IMPROVEMENT PERMIT / AUTHORIZATION TO CONSTRUCT / OPERATION PERMIT / EXISTING SYSTEM

PIN # 4737773149

APPLICANT: Charles W. Massie APPLICANT ADDRESS: 4622 Sunrise Beach Rd Catawba NC 28609

SITE ADDRESS: 385 Bluegill Ln Statesville NC 28625 PHONE: 865-776-7146 ALT. PHONE: N/A

SITE DIRECTIONS: N to Chipley Ford Rd T/R Bluegill Ln on left at end in cul-de-sac


SUBDIVISION: Poplar Ridge SECTION: P2 LOT # 28 LOT AREA: 3.117ac DESIGN FLOW: 480 L.T.A.R.: 0.3

Septic Tank	1000	(gal)	STB		Date		[X] New System	[ ] Repair	[ ] Expansion	System Type: I II III IV V VI	[X] Residence	No. Bedrooms	4	Water Supply			
Pump Tank		(gal)	PT		Date		System Description:	25% Reduction			[ ] Business	No. Persons	3	[ ] Private			
Pump Make		Model			Serial #		Repair System Description:	25% Reduction			[ ] Other	No. Employees		[X] Public			
# Nitrification Fields	1	# Lines	4		Linear Ft:	400	Maintenance Agreement Required:	[ ] YES	[X] NO		[ ] Slab	[X] Crawl Space		[ ] Community			
Trench Width	36"	Max. Trench Bottom Depth	36"		Gravel Depth	N/A	[X] GRAVITY	[ ] PRESSURE			[ ] Basement w/plumbing			[ ] Basement w/o plumbing			


Comments / Conditions:

All building foundations must be 35' from any part of STS

INITIAL SITE SKETCH

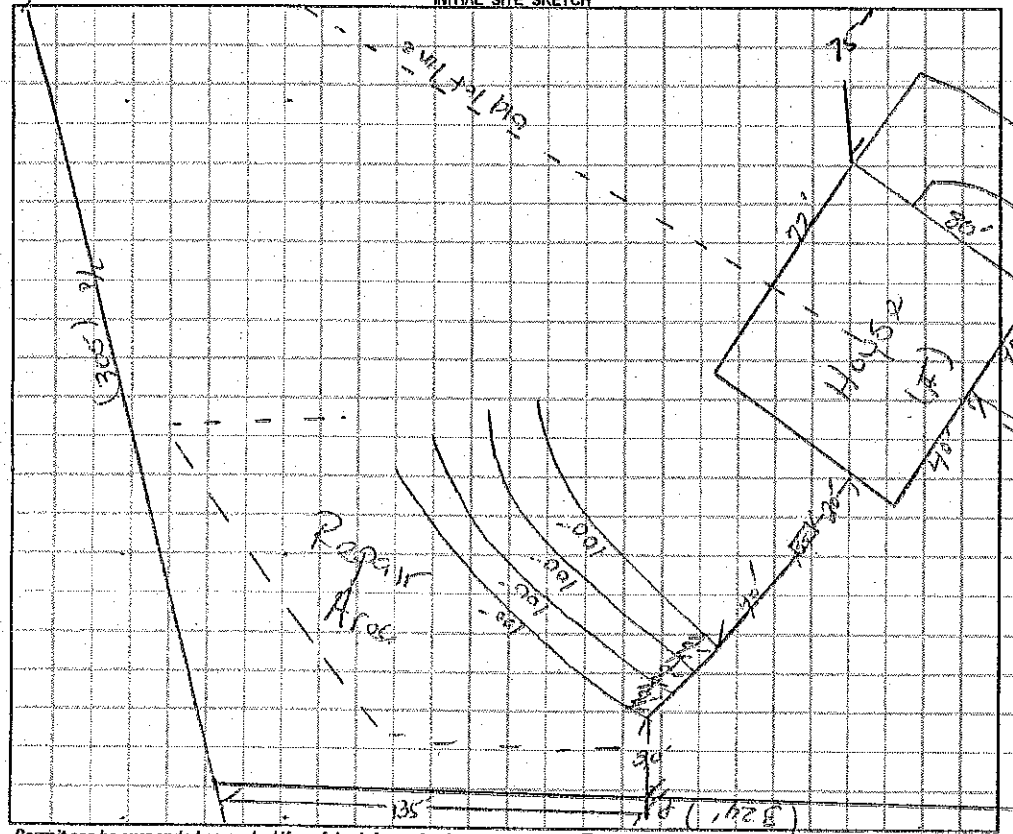

AS BUILT SKETCH

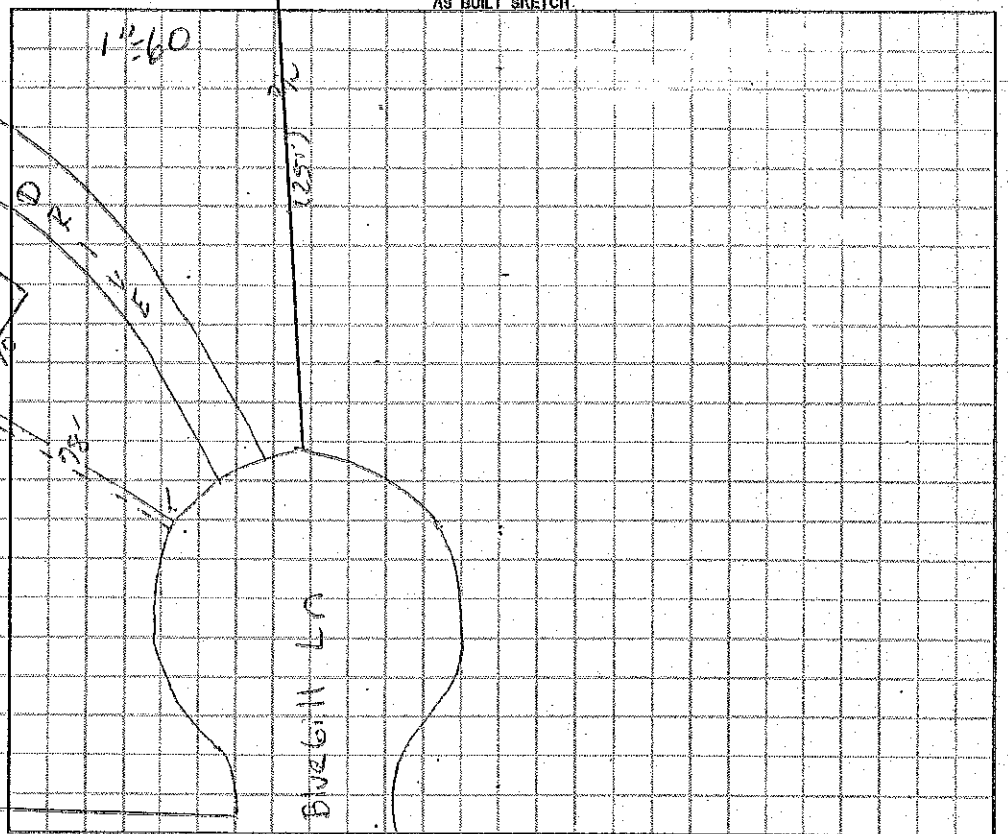

Permit can be suspended or revoked if any false information is supplied toward securing the permit / any unauthorized changes are made to the site / any unauthorized changes are made in the installation of the system. **CONTACT A LOCATOR SERVICE PRIOR TO ANY EXCAVATION!**

[ ] **IMPROVEMENT PERMIT** *with plat valid without expiration.* **IMPROVEMENT PERMIT** *with site plan valid for 60 mos.* [ ] **AUTHORIZATION TO CONSTRUCT** *valid for period equal to IMPROVEMENT PERMIT--not to exceed 60 mo.*

Owner / Applicant Signature: Charles W Massie Date: 10/9/15 Installed by:

IMPROVEMENT PERMIT by: Date: OPERATION PERMIT by: Date:

AUTHORIZATION TO CONSTRUCT by: Date: Existing System Inspected by: Date: 08/20/15

Health Dept. Copy - WHITE Applicant (Final Approval) - YELLOW Applicant (Conditional Approval) - PINK