IREDELL COUNTY HEALTH DEPARTMENT

Statesville Office (704) 878-5305 Mooresville Office (704) 660-3625 PERMIT # 206780

IMPROVEMENT PERMIT / AUTHORIZATION TO CONSTRUCT / OPERATION PERMIT / EXISTING SYSTEM

PIN # 4737774858

APPLICANT: Theresa Patton APPLICANT ADDRESS: 482 Barry Oak Rd

SITE ADDRESS: 122 Breeze Hill Place PHONE: 704-902-8727 ALT. PHONE: N/A


SITE DIRECTIONS: Hwy 115N TR S Chapley Ford Rd TR Bluegill Rd. TR Breeze Hill Place

SUBDIVISION: Poplar Ridge SECTION: 2 LOT # 19 LOT AREA: 1.54 acres DESIGN FLOW: 360gpd L.T.A.R.: 0.275


Septic Tank	1000 (gal)	STB	1012-1000	Date	3-11-14	☑ New System ☐ Repair ☐ Expansion	System Type: I II III IV V VI	☑ Residence	No. Bedrooms	3	Water Supply
Pump Tank	(gal)	PT		Date		System Description:	25% Reduction	☐ Business	No. Persons	6	☐ Private
Pump Make		Model		Serial #		Repair System Description:	25% Reduction	☐ Other	No. Employees		☑ Public
# Nitrification Fields	1	# Lines	4	Linear Ft:	328	Maintenance Agreement Required:	☐ YES ☑ NO	☐ Slab	☑ Crawl Space		☐ Community
Trench Width	36"	Max. Trench Bottom Depth	36"	Gravel Depth	N/A		☑ GRAVITY ☐ PRESSURE	☐ Basement w/plumbing	☐ Basement w/o plumbing		

Comments / Conditions: IMPROVEMENTS ONLY! Submit floor plan prior to issuance of CA. Install a 25% Reduction system on contour with serial distribution.

INITIAL SITE SKETCH

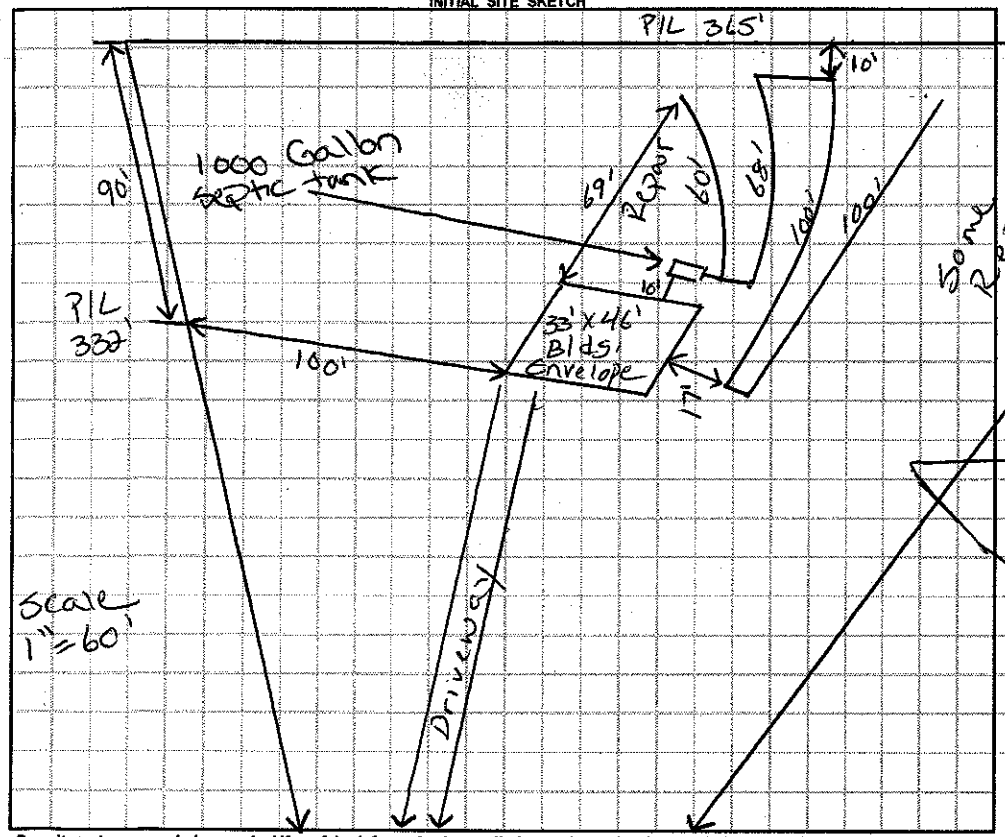

AS BUILT SKETCH

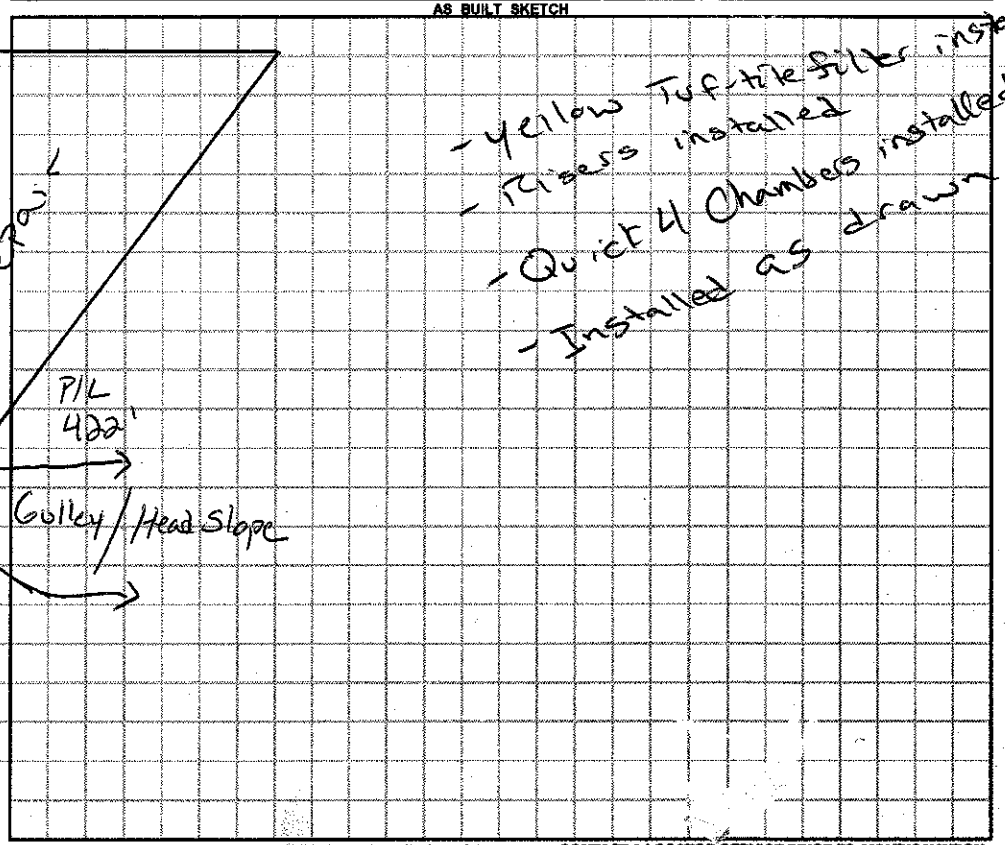

Permit can be suspended or revoked if any false information is supplied toward securing the permit / any unauthorized changes are made to the site / any unauthorized changes are made in the installation of the system. **CONTACT A LOCATOR SERVICE PRIOR TO ANY EXCAVATION**

☐ **IMPROVEMENT PERMIT** *with plat valid without expiration.* ☑ **IMPROVEMENT PERMIT** *with site plan valid for 60 mos.* ☑ **AUTHORIZATION TO CONSTRUCT** *valid for period equal to IMPROVEMENT PERMIT--not to exceed 60 mo.*

Owner / Applicant Signature: [signature] Date: 12-6-14 Installed by: Steve Jordan

IMPROVEMENT PERMIT by: Justin Henderson Date: 12-5-14 OPERATION PERMIT by: Justin Henderson Date: 8-26-15

AUTHORIZATION TO CONSTRUCT by: Justin Henderson Date: 12-8-14 Existing System Inspected by: Date:

Health Dept. Copy - WHITE Applicant (Final Approval) - YELLOW Applicant (Conditional Approval) - PINK