IREDELL COUNTY HEALTH DEPARTMENT

STATESVILLE 704-878-5305 (at) MOORESVILLE 704-664-5281

IMPROVEMENT PERMIT / AUTHORIZATION TO CONSTRUCT / OPERATION PERMIT / EXISTING SYSTEM INSPECTION

PERMIT # 150804 PIN # 4737775182 DATE 4-20-09

OWNER or APPLICANT Dixieland, Inc. PHONE: Business 704 202 4971 Home: 704 876 6162

OWNER or APPLICANT ADDRESS 133 Redemption Rd

LOCATION / DIRECTIONS 379 Bluegill Ln

SUBDIVISION Poplar Ridge BLOCK / SECTION 2 LOT # 30 LOT AREA .921 DESIGN FLOW 360 L.T.A.R. .3

Septic Tank 1000 Gallons: STB 525 Date 10-1-09

Pump Tank ____ Gallons: P T ____ Date ____

Pump Make ____ Model ____ Serial # ____

Nitrification Field No Fields 1 No Lines 3 Linear Feet 300'

Trench Width 36" Max. Trench Bottom Depth 36" Gravel Depth n/a

☒ New System ☐ Repair ☐ Expansion System Type I II III IV V VI

System Description: 25% Reduction Gravity

Repair System Description: 25% Reduction Gravity

Maintenance Agreement Required ☐ YES ☒ NO

☒ GRAVITY ☐ PRESSURE

☒ Residence No. Bedrooms 3 ☐ Business No. Persons ____ ☐ Other No. Employees ____

☐ Slab ☒ Crawl Space ☐ Basement w/plumbing ☐ Basement w/o plumbing


Water Supply: ☐ Private ☐ Public ☒ Community

Comments / Conditions


Comments / Conditions

Septic Marker

INITIAL SITE SKETCH

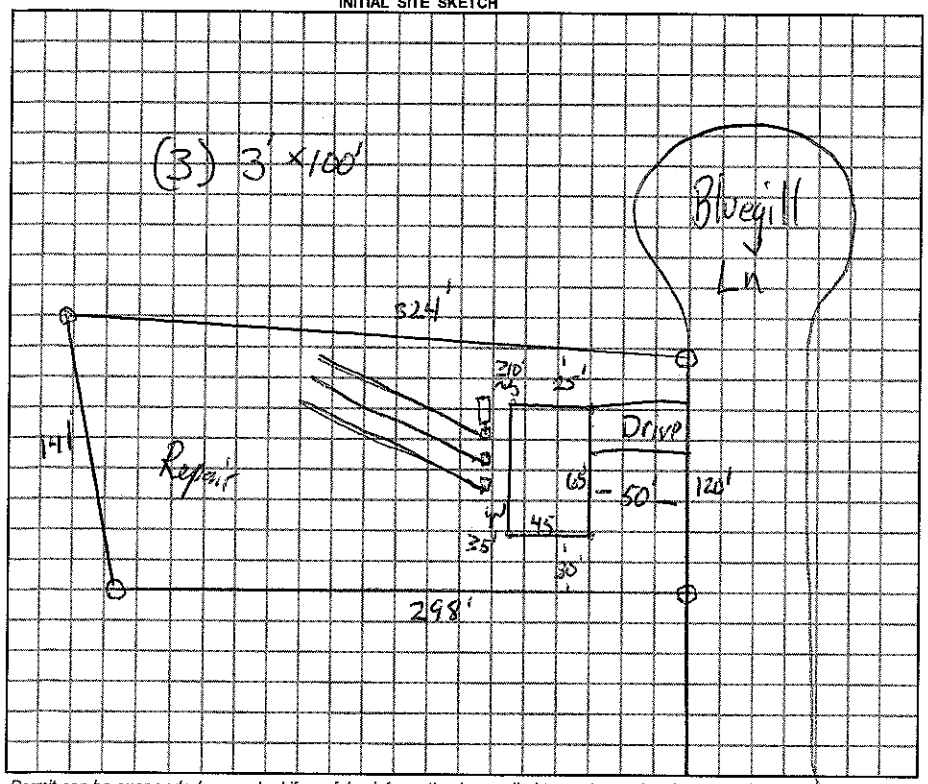

AS BUILT SKETCH

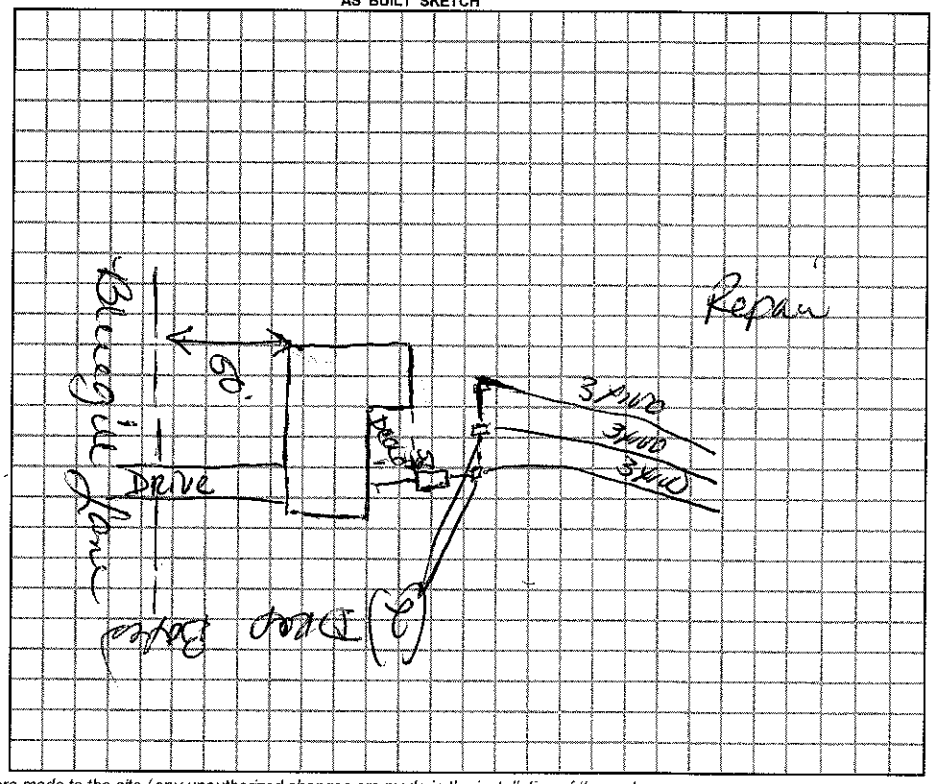

Permit can be suspended or revoked if any false information is supplied toward securing the permit / any unauthorized changes are made to the site / any unauthorized changes are made in the installation of the system.

☐ *IMPROVEMENT PERMIT w / plat valid without expiration.* ☒ *IMPROVEMENT PERMIT w / site plan valid for 60 mos.* ☒ *AUTHORIZATION TO CONSTRUCT valid for period equal to IMPROVEMENT PERMIT-not to exceed 60 mo.*

Owner / Applicant Signature: Regina C Dodd Date 4/24/09

Improvement Permit by: James Date 4-20-09

Authorzation to Construct by: James Date 4-20-09

YOU SHOULD CONTACT A LOCATOR SERVICE PRIOR TO ANY EXCAVATION.

Installed by: Bowman Septic

Operation Permit by: Kenny Cook Date: 7-14-09

Existing System Inspected by: ____ Date: ____

WHITE COPY Environmental Health YELLOW COPY (Final) Owner / Applicant PINK COPY (Initial) Owner / Applicant