11:00 1:45 2 See attached permit #106867 for out building addition 5/26/11.

IREDELL COUNTY HEALTH DEPARTMENT - *ENVIRONMENTAL HEALTH* ☑ STATESVILLE OFFICE 704-878-5305 ☐ MOORESVILLE OFFICE 704-664-5281

IMPROVEMENT PERMIT / AUTHORIZATION TO CONSTRUCT / OPERATION PERMIT / EXISTING SYSTEM INSPECTION

PERMIT # 164534 PIN # 4737-77-9151 DATE 7 January 11

OWNER Dixieland, Inc. APPLICANT: PHONE: Home/Cell # (704) 202-4971 Business #

SITE ADDRESS 367 Bluegill Ln. Statesville OWNER / APPLICANT ADDRESS

SITE DIRECTIONS Chipley Ford Rd. TR Bluegill Ln. Lot on left near end.

SUBDIVISION Poplar Ridge BLOCK / SECTION LOT # 32 LOT AREA 0.93 ac. DESIGN FLOW 360 gpd L.T.A.R. 0.3 gpd/ft²

Septic Tank 1000 Gallons: STB 760 Date 10-29-10 ☑ New System ☐ Repair ☐ Expansion System Type I II (III) IV V VI

Pump Tank Gallons: P T Date System Description: 25% Reduction

Pump Make Model Serial # Repair System Description: 25% Reduction

No. Nitrification Fields: 1 No. Lines 5 Linear Feet 300 Maintenance Agreement Required ☐ YES ☑ NO


Trench Width 36" Max. Trench Bottom Depth 36" Gravel Depth NA ☑ GRAVITY ☐ PRESSURE

☑ Residence No. Bedrooms 3 ☐ Business No. Persons ☐ Other No. Employees ☐ Slab ☑ Crawl Space ☐ Basement w/plumbing ☐ Basement w/o plumbing

Water Supply: ☐ Private ☑ Public ☐ Community

Comments / Conditions * Fill the ditches and keep minimum of 5' of separation with nitrification lines.

INITIAL SITE SKETCH

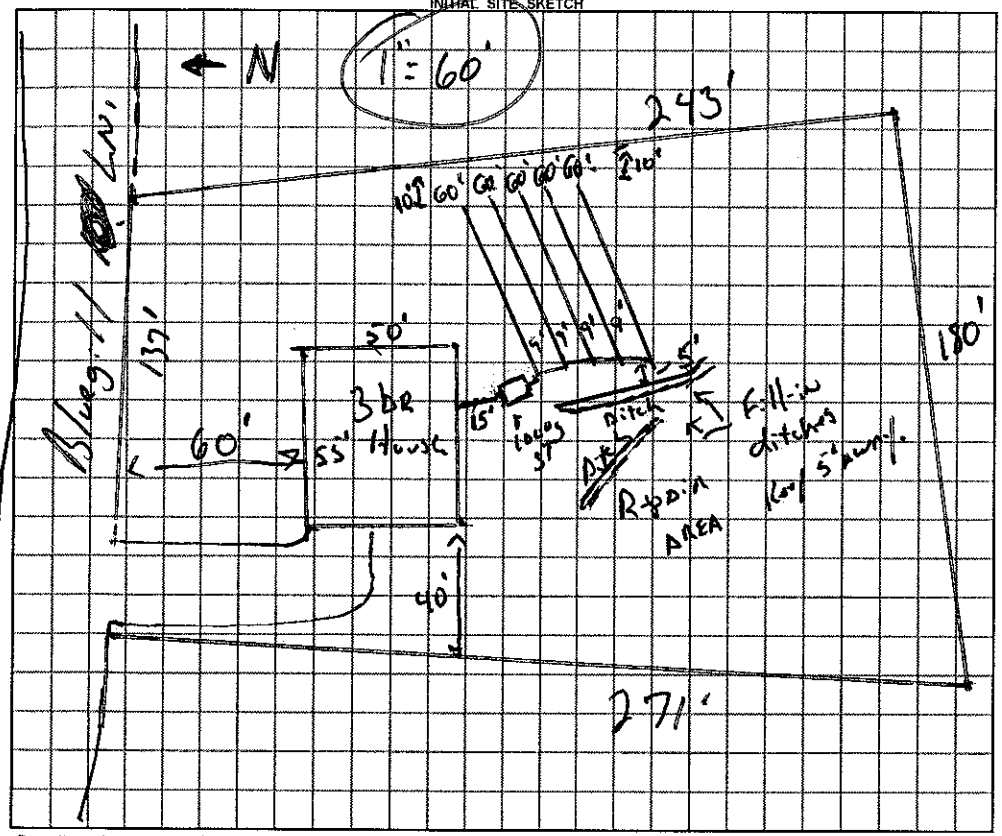

AS BUILT SKETCH

Permit can be suspended or revoked if any false information is supplied toward securing the permit / any unauthorized changes are made to the site / any unauthorized changes are made in the installation of the system.

☐ ***IMPROVEMENT PERMIT*** with plat valid without expiration. ☑ ***IMPROVEMENT PERMIT*** with plat valid ~~without expiration.~~ 60 mos. ☑ ***AUTHORIZATION TO CONSTRUCT*** valid for period equal to IMPROVEMENT PERMIT--not to exceed 60 mo.

Owner / Applicant Signature: Regina C Darville Date 1/12/11 Installed by: Gunter Grading

IMPROVEMENT PERMIT by: REHS Date 7 Jan. 11 OPERATION PERMIT by: REHS Date 4-19-11

AUTHORIZATION TO CONSTRUCT by: REHS Date 7 Jan. 11 Existing System Inspected by: REHS Date

YOU SHOULD CONTACT A LOCATOR SERVICE PRIOR TO ANY EXCAVATION

White Copy – Environmental Health YELLOW COPY (Final) Owner / Applicant PINK COPY (Initial) Owner / Applicant