Site address: 282 Bluegill Ln - Statesville

IREDELL COUNTY HEALTH DEPARTMENT

STATESVILLE 704-878-5305 | MOORESVILLE 704-664-5281

IMPROVEMENT PERMIT / AUTHORIZATION TO CONSTRUCT / OPERATION PERMIT / EXISTING SYSTEM INSPECTION

PERMIT # 158724 PIN # 4737-78-7523 DATE 6 November 09

OWNER or APPLICANT Dixieland, Inc. PHONE: Business (704) 876-6162 Home:

OWNER or APPLICANT ADDRESS 823 Jennings Rd Statesville, N.C.

LOCATION / DIRECTIONS Shipley Ford Rd. Turn onto Bluegill - Go into Poplar Ridge - Lot on Rt.

SUBDIVISION Poplar Ridge BLOCK / SECTION LOT # 10 LOT AREA DESIGN FLOW 360g/d L.T.A.R. 0.3g/ft²/d

Septic Tank 1000g Gallons: STB 760 Date 2-26

Pump Tank Gallons: P T Date

Pump Make Model Serial #

Nitrification Field No Fields 1 No Lines 3 Linear Feet 300

Trench Width 36" Max. Trench Bottom Depth 36" Gravel Depth NA

☑ New System ☐ Repair ☐ Expansion System Type I II (III) IV V VI

System Description: 25% Reduction

Repair System Description: 25% Reduction

Maintenance Agreement Required ☐ YES ☑ NO

☑ GRAVITY ☐ PRESSURE

☑ Residence No. Bedrooms 3

☐ Business No. Persons

☐ Other No. Employees

☐ Slab ☑ Crawl Space


☐ Basement w/plumbing ☐ Basement w/o plumbing

Water Supply: ☐ Private ☑ Public ☐ Community


Comments / Conditions: Full Hollow Area NEXT TO System Area. Keep 5' from Hollow.

Comments / Conditions: Polylock filter Crawl Tee

INITIAL SITE SKETCH

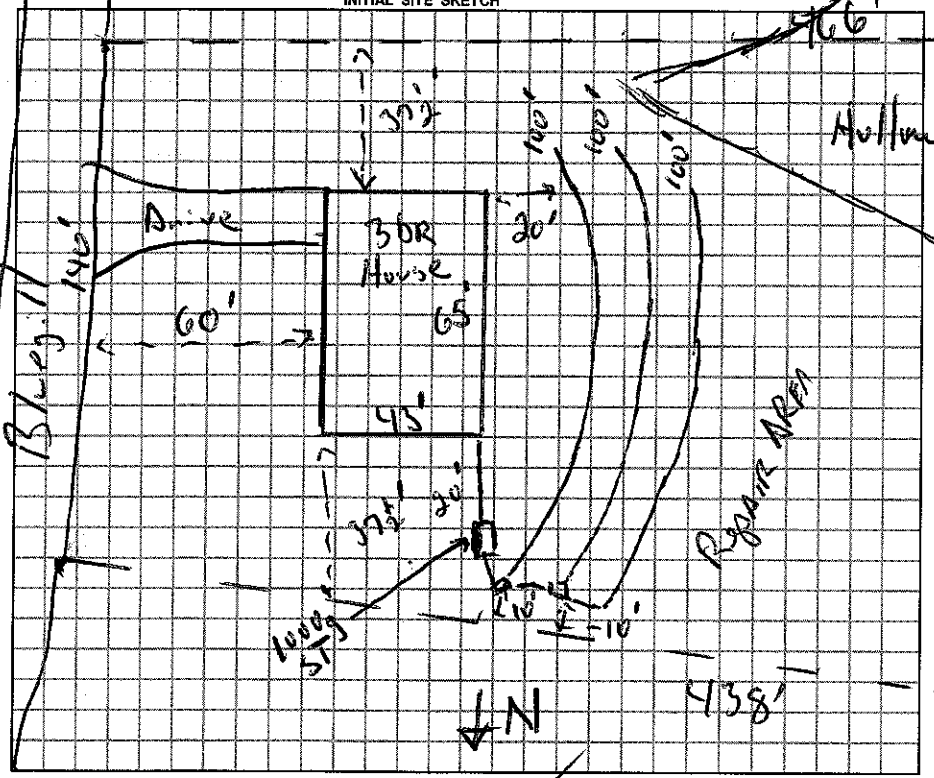

AS BUILT SKETCH

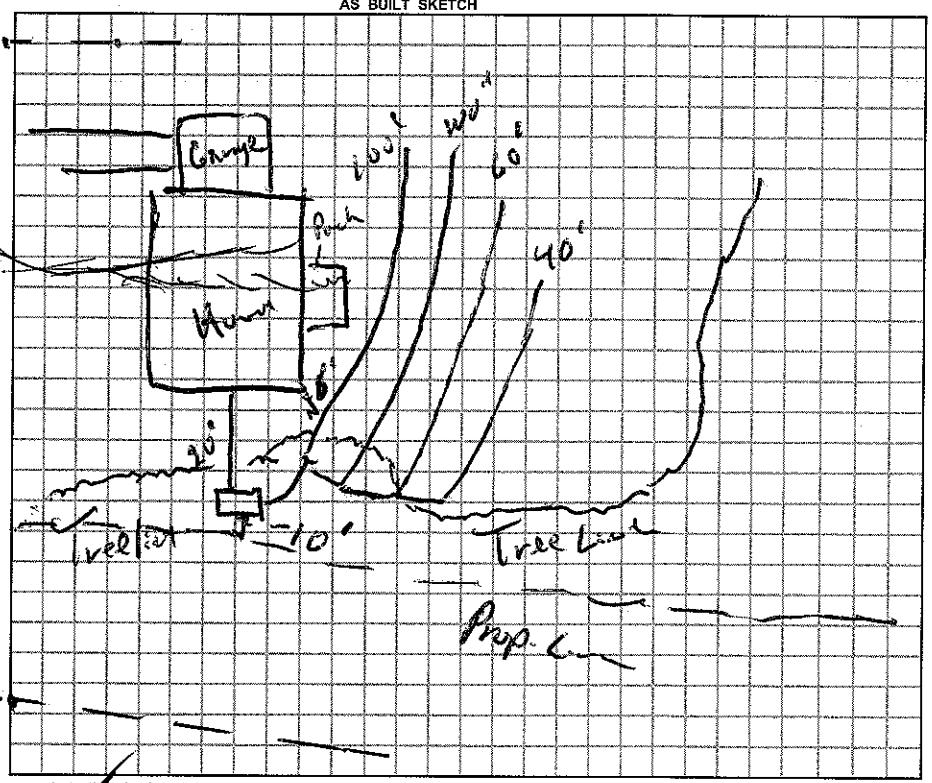

Permit can be suspended or revoked if any false information is supplied toward securing the permit / any unauthorized changes are made to the site / any unauthorized changes are made in the installation of the system.

☐ *IMPROVEMENT PERMIT w / plat valid without expiration.* ☑ *IMPROVEMENT PERMIT w / site plan valid for 60 mos.* ☑ *AUTHORIZATION TO CONSTRUCT valid for period equal to IMPROVEMENT PERMIT-not to exceed 60 mo.*

Owner / Applicant Signature: Tamra C Randle Date 11/16/09

Improvement Permit by: [signature] R.S. Date 6 Nov. 09

Authorization to Construct by: [signature] R.S. Date 6 Nov. 09

YOU SHOULD CONTACT A LOCATOR SERVICE PRIOR TO ANY EXCAVATION.

Installed by: Shipley Environmental

Operation Permit by: [signature] R.S. Date: 6 May 10

Existing System Inspected by: Date:

WHITE COPY Environmental Health YELLOW COPY (Final) Owner / Applicant PINK COPY (Initial) Owner / Applicant