IREDELL COUNTY HEALTH DEPARTMENT - *ENVIRONMENTAL HEALTH* ☒ STATESVILLE OFFICE 704-878-5305 ☐ MOORESVILLE OFFICE 704-664-5281

IMPROVEMENT PERMIT / AUTHORIZATION TO CONSTRUCT (01) / OPERATION PERMIT (01) / EXISTING SYSTEM INSPECTION

PERMIT # 167484 PIN # 4737874540 DATE 7-19-11

OWNER Dixieland APPLICANT: PHONE: Home/Cell # 704 202 4971 Business #

SITE ADDRESS 339 Bluegill Ln. OWNER / APPLICANT ADDRESS

SITE DIRECTIONS 21 N, (TL) Shoemaker, (TL) Ingram (R) Chipley Ford ~ 2 miles (R) on Bluegill, lot on (L)

SUBDIVISION Poplar Ridge BLOCK / SECTION LOT # 37 LOT AREA 1.404 Ac. DESIGN FLOW 360 L.T.A.R. .3

Septic Tank 1000 Gallons: STB 825 Date 9/6-11 ☒ New System ☐ Repair ☐ Expansion System Type I II (III) IV V VI ☒ Residence No. Bedrooms 3 Water Supply

Pump Tank Gallons: PT Date ☐ Business No. Persons ☐ Private

Pump Make Model Serial # ☐ Other No. Employees ☒ Public

No. Nitrification Fields: 1 No. Lines 3 Linear Feet 300 total ☐ Slab ☒ Crawl Space ☐ Community

Trench Width 36" Max. Trench Bottom Depth 36" Gravel Depth n/a ☒ GRAVITY ☐ PRESSURE ☐ Basement w/plumbing ☐ Basement w/o plumbing


System Description: 25% Reduction - Gravity

Repair System Description: 25% Reduction - Gravity


Maintenance Agreement Required ☐ YES ☒ NO

Comments / Conditions

INITIAL SITE SKETCH

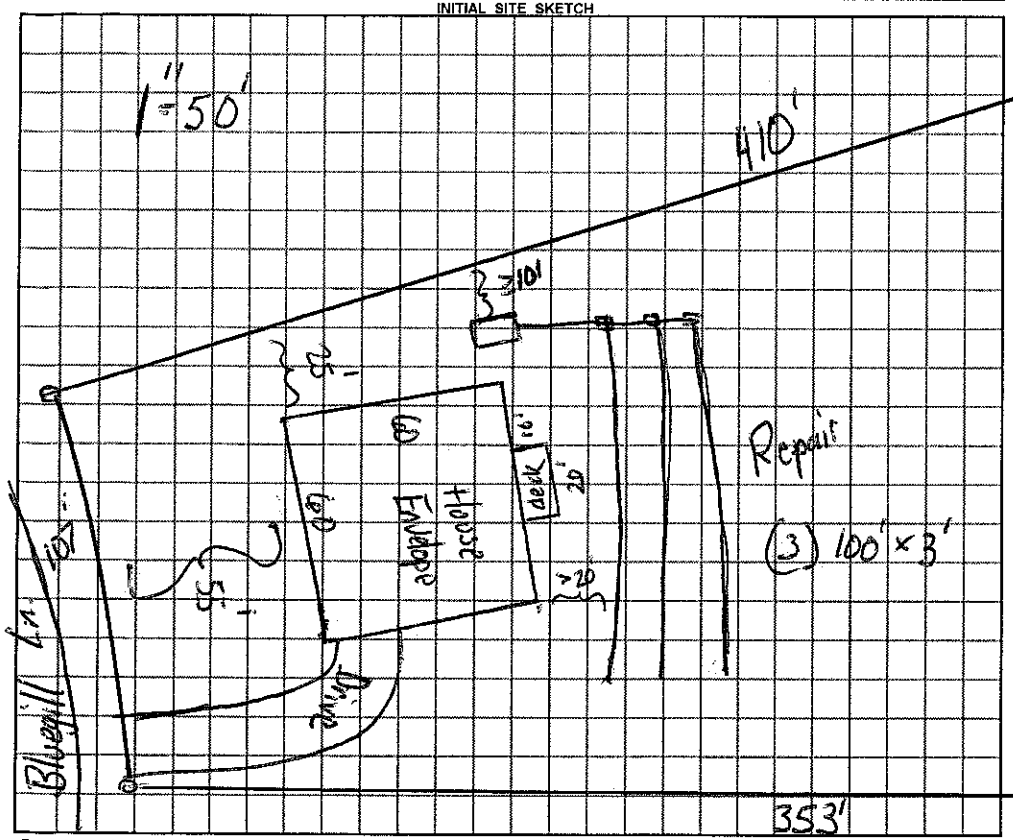

AS BUILT SKETCH

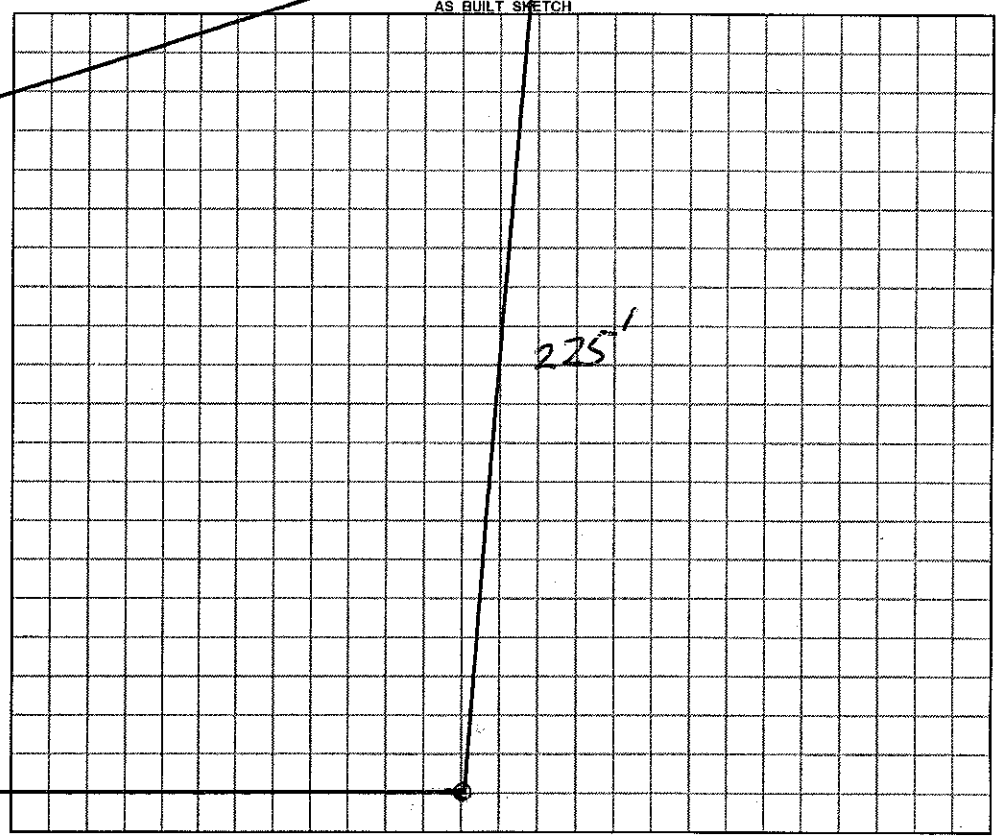

Permit can be suspended or revoked if any false information is supplied toward securing the permit / any unauthorized changes are made to the site / any unauthorized changes are made in the installation of the system.

☐ ***IMPROVEMENT PERMIT*** with plat valid without expiration. ☒ ***IMPROVEMENT PERMIT*** with ~~plat valid without expiration.~~ site plan valid 60 mo. ☒ ***AUTHORIZATION TO CONSTRUCT*** valid for period equal to IMPROVEMENT PERMIT--not to exceed 60 mo.

Owner / Applicant Signature: Loyria C Dowdle Date 7-21-11 Installed by: Rowan Septic

IMPROVEMENT PERMIT by: REHS Date 7-19-11 OPERATION PERMIT by: REHS Date 11-14-11

AUTHORIZATION TO CONSTRUCT by: REHS Date 7-19-11 Existing System Inspected by: REHS Date

YOU SHOULD CONTACT A LOCATOR SERVICE PRIOR TO ANY EXCAVATION

White Copy – Environmental Health YELLOW COPY (Final) Owner / Applicant PINK COPY (Initial) Owner / Applicant