2:30

IREDELL COUNTY HEALTH DEPARTMENT - *ENVIRONMENTAL HEALTH* ☒ STATESVILLE OFFICE 704-878-5305 ☐ MOORESVILLE OFFICE 704-664-5281

IMPROVEMENT PERMIT / AUTHORIZATION TO CONSTRUCT / OPERATION PERMIT / EXISTING SYSTEM INSPECTION

PERMIT # 168805 PIN # 4737-88-2352 DATE 10-19-11

OWNER Dixieland Inc. APPLICANT: PHONE: Home/Cell # 704-202-4971 Business #

SITE ADDRESS 295 Bluegill OWNER / APPLICANT ADDRESS

SITE DIRECTIONS N on Chipley Ford, (R) on Bluegill, lot on (L)

SUBDIVISION Poplar Ridge BLOCK / SECTION LOT # 44 LOT AREA 1.4 Ac. DESIGN FLOW 360 L.T.A.R. .3

Septic Tank 1000 Gallons: STB 1012 Date 9-29-11

Pump Tank Gallons: P T Date

Pump Make Model Serial #

No. Nitrification Fields: 1 No. Lines 3 Linear Feet 300

Trench Width 36" Max. Trench Bottom Depth 36" Gravel Depth n/a

☒ New System ☐ Repair ☐ Expansion System Type I II (III) IV V VI

System Description: 25% Reduction Gravity

Repair System Description: 25% Reduction Gravity

Maintenance Agreement Required ☐ YES ☒ NO

☒ GRAVITY ☐ PRESSURE

☒ Residence No. Bedrooms 3

☐ Business No. Persons

☐ Other No. Employees


☐ Slab ☒ Crawl Space

☐ Basement w/plumbing ☐ Basement w/o plumbing


Water Supply: ☒ Private ☐ Public ☐ Community

Comments / Conditions

INITIAL SITE SKETCH

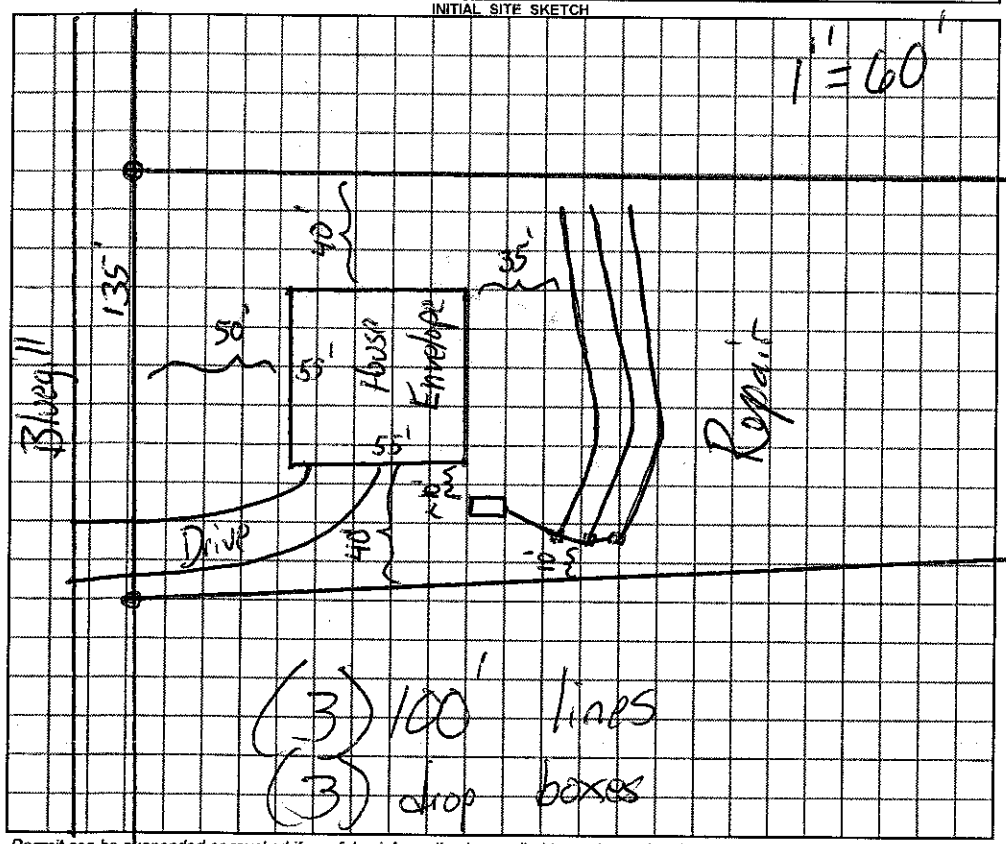

AS BUILT SKETCH

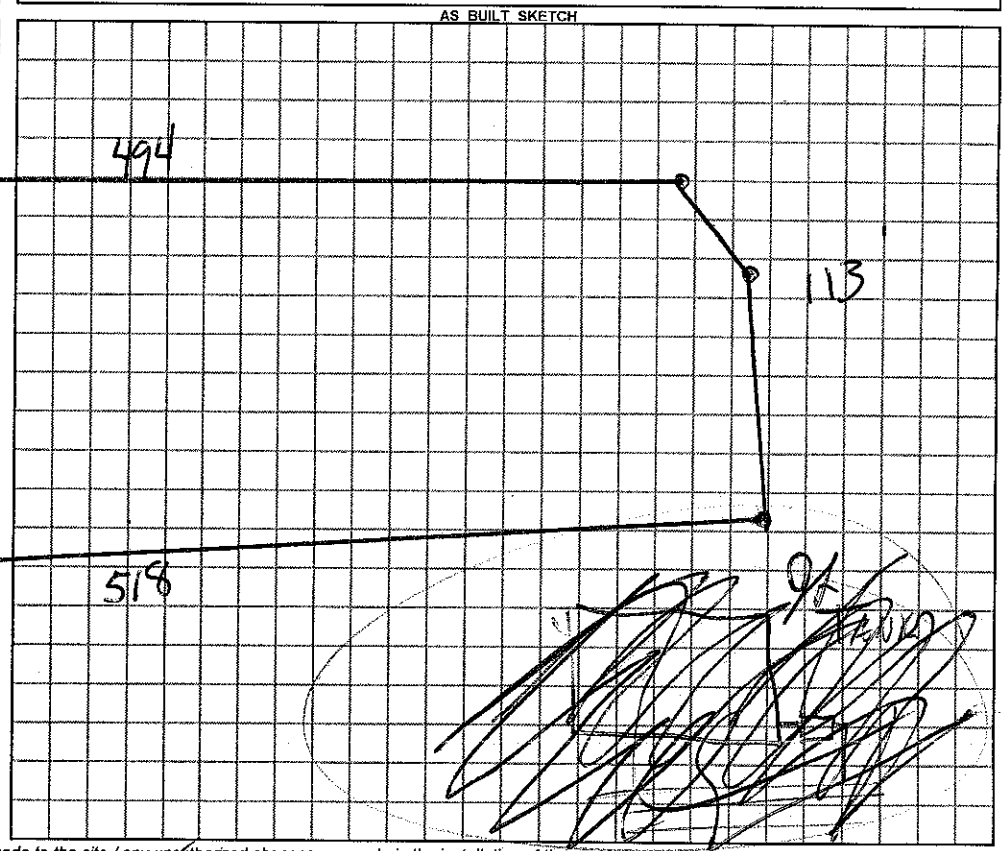

Permit can be suspended or revoked if any false information is supplied toward securing the permit / any unauthorized changes are made to the site / any unauthorized changes are made in the installation of the system.

☐ ***IMPROVEMENT PERMIT*** with plat valid without expiration. ☒ ***IMPROVEMENT PERMIT*** with ~~plat valid without expiration~~ ***site plan valid 60 mo.*** ☒ ***AUTHORIZATION TO CONSTRUCT*** valid for period equal to IMPROVEMENT PERMIT--not to exceed 60 mo.

Owner / Applicant Signature: Kenneth C Dowdle Date 11/8/11 Installed by: Steve Jordan

IMPROVEMENT PERMIT by: James REHS Date 10-19-11 OPERATION PERMIT by: James REHS Date 2-15-12

AUTHORIZATION TO CONSTRUCT by: James REHS Date 10-19-11 Existing System Inspected by: REHS Date

YOU SHOULD CONTACT A LOCATOR SERVICE PRIOR TO ANY EXCAVATION

White Copy – Environmental Health YELLOW COPY (Final) Owner / Applicant PINK COPY (Initial) Owner / Applicant