IREDELL COUNTY HEALTH DEPARTMENT - *ENVIRONMENTAL HEALTH* ☒ STATESVILLE OFFICE 704-878-5305 ☐ MOORESVILLE OFFICE 704-664-5281

IMPROVEMENT PERMIT / AUTHORIZATION TO CONSTRUCT / OPERATION PERMIT / EXISTING SYSTEM INSPECTION

PERMIT # 172272 PIN # 4737890769 DATE 5-21-12

OWNER Dixieland Construction APPLICANT: PHONE: Home/Cell # 704-876-6162 Business # 704-202-4971

SITE ADDRESS 223 Bluegill Lane OWNER / APPLICANT ADDRESS 133 Redemption Road

SITE DIRECTIONS 115N (R) on Chipley Ford. Go 6 miles, turn (R) on Bluegill into Poplar Ridge - 2nd lot on left

SUBDIVISION Poplar Ridge BLOCK / SECTION LOT # 58 LOT AREA DESIGN FLOW L.T.A.R.

Septic Tank 1000 Gallons: STB 1012 Date 11-3-11 ☒ New System ☐ Repair ☐ Expansion System Type I II III IV V VI

Pump Tank Gallons: P T Date System Description: 25% Reduction - Gravity

Pump Make Model Serial # Repair System Description: 25% Reduction Pump

No. Nitrification Fields: 1 No. Lines 4 Linear Feet 300 Maintenance Agreement Required ☐ YES ☒ NO

Trench Width 36" Max. Trench Bottom Depth 36" Gravel Depth n/a ☒ GRAVITY ☐ PRESSURE


☒ Residence ☐ Business ☐ Other ☐ Slab ☒ Crawl Space ☐ Basement w/plumbing ☐ Basement w/o plumbing

No. Bedrooms 3 No. Persons No. Employees


Water Supply ☐ Private ☒ Public ☐ Community

Comments / Conditions

INITIAL SITE SKETCH

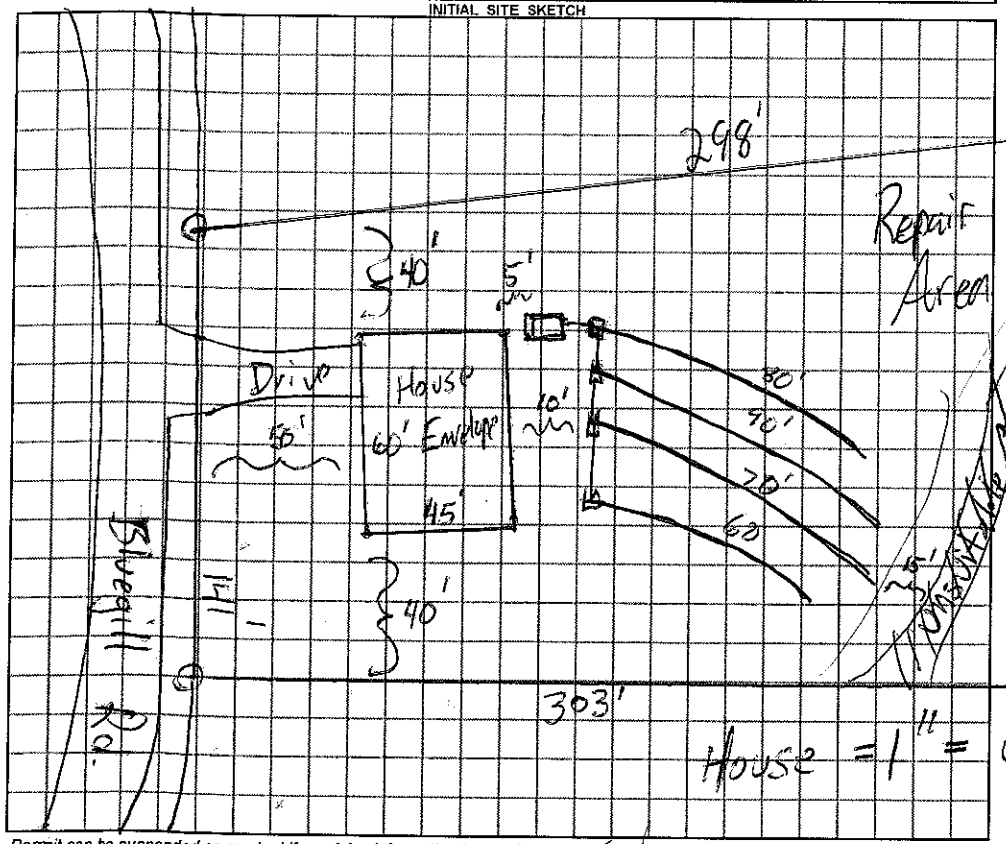

AS BUILT SKETCH

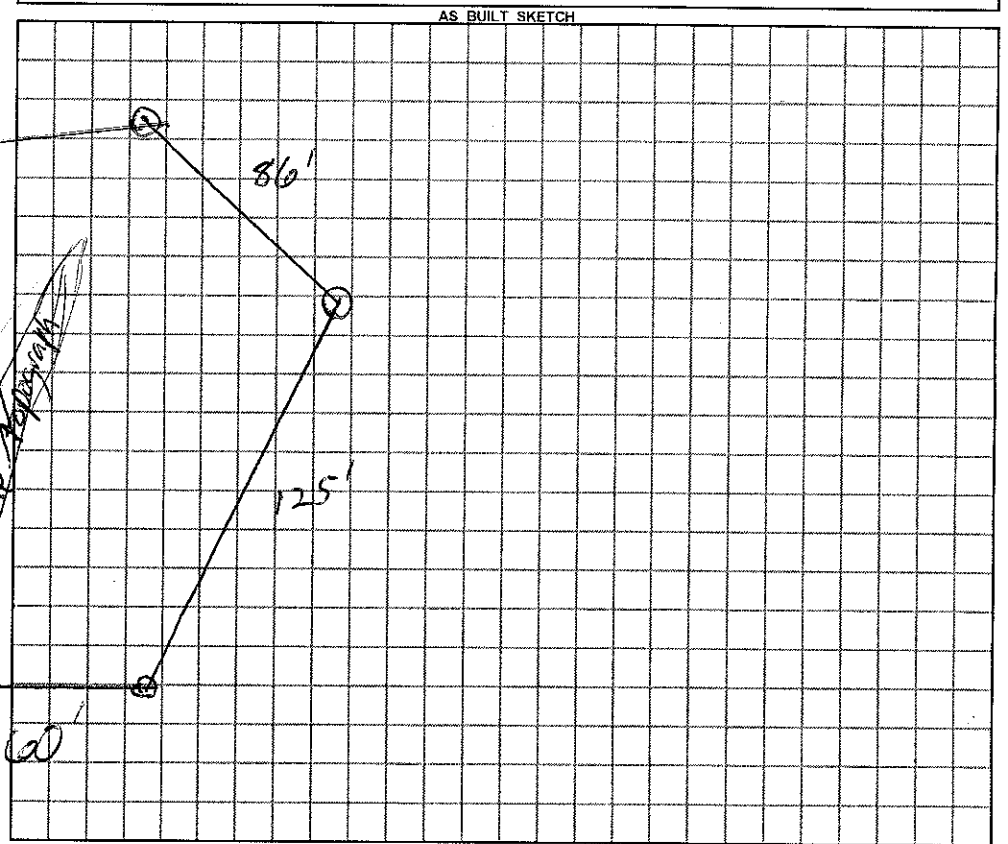

Permit can be suspended or revoked if any false information is supplied toward securing the permit / any unauthorized changes are made to the site / any unauthorized changes are made in the installation of the system.

☐ ***IMPROVEMENT PERMIT*** *with plat valid without expiration.* ☒ ***IMPROVEMENT PERMIT*** *with ~~plat valid without expiration.~~ site plan valid 60 mo.* ☒ ***AUTHORIZATION TO CONSTRUCT*** valid for period equal to IMPROVEMENT PERMIT--not to exceed 60 mo.

Owner / Applicant Signature: Regina Dayvault Date 6/7/12 Installed by: Piedmont Grading

IMPROVEMENT PERMIT by: REHS Date 5-21-12 OPERATION PERMIT by: REHS Date 7.12.12

AUTHORIZATION TO CONSTRUCT by: REHS Date 5-21-12 Existing System Inspected by: REHS Date

YOU SHOULD CONTACT A LOCATOR SERVICE PRIOR TO ANY EXCAVATION

White Copy – Environmental Health YELLOW COPY (Final) Owner / Applicant PINK COPY (Initial) Owner / Applicant